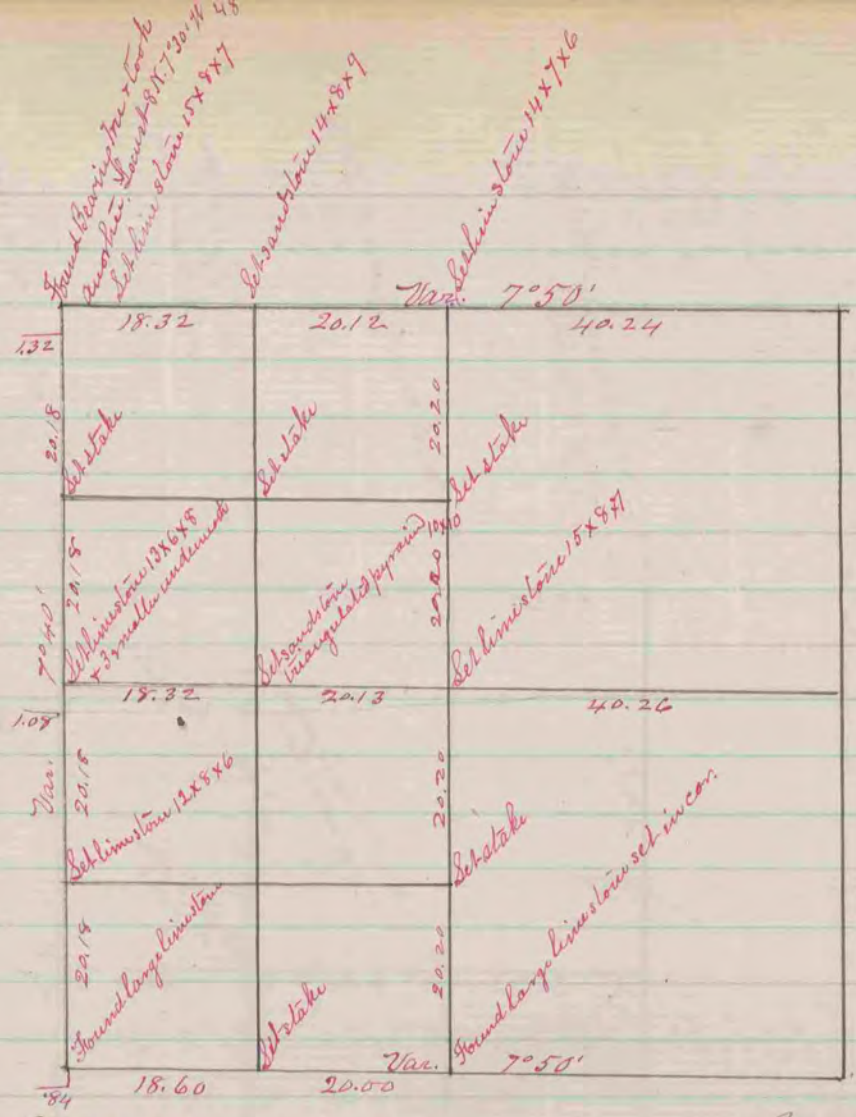

Record & Plat of a survey made on Sec. 19. T. 3. R. 11. E June 10 1863 by S. D. Locke Co. Surveyor Center

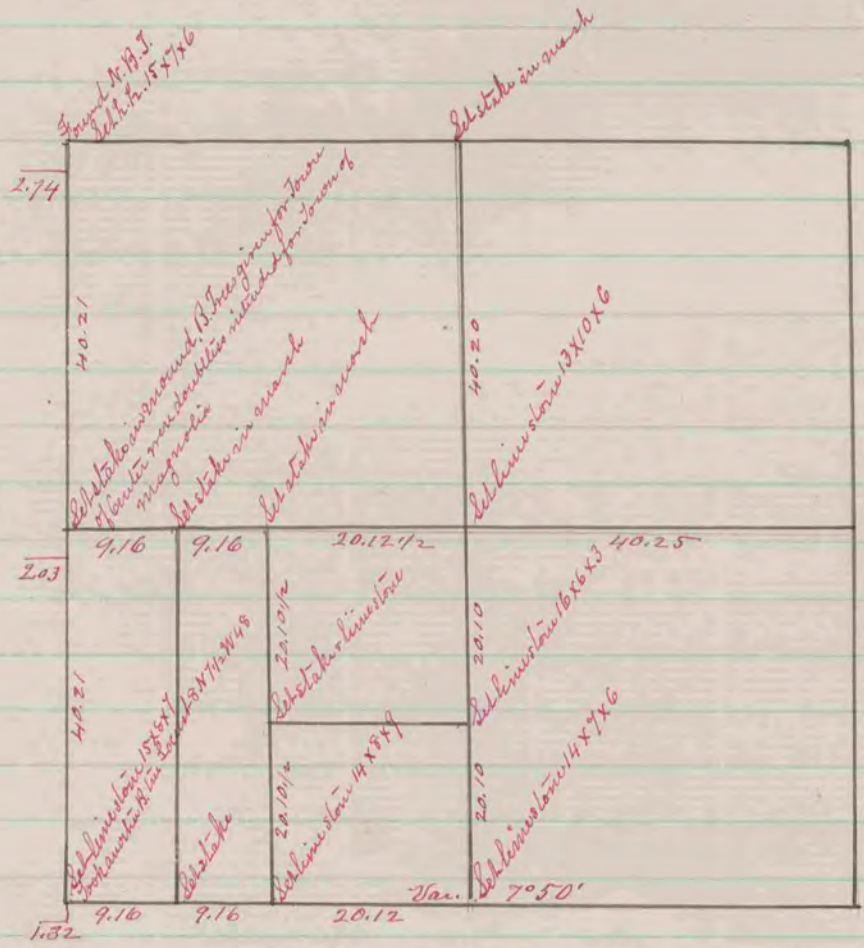

Record & Plat of a Survey made June 11. 1863 on Sec. 18. T. 3. R. 11. E by S. D. Locke County Surveyor Center

COUNTY SURVEYOR
RECORD 1859-1906