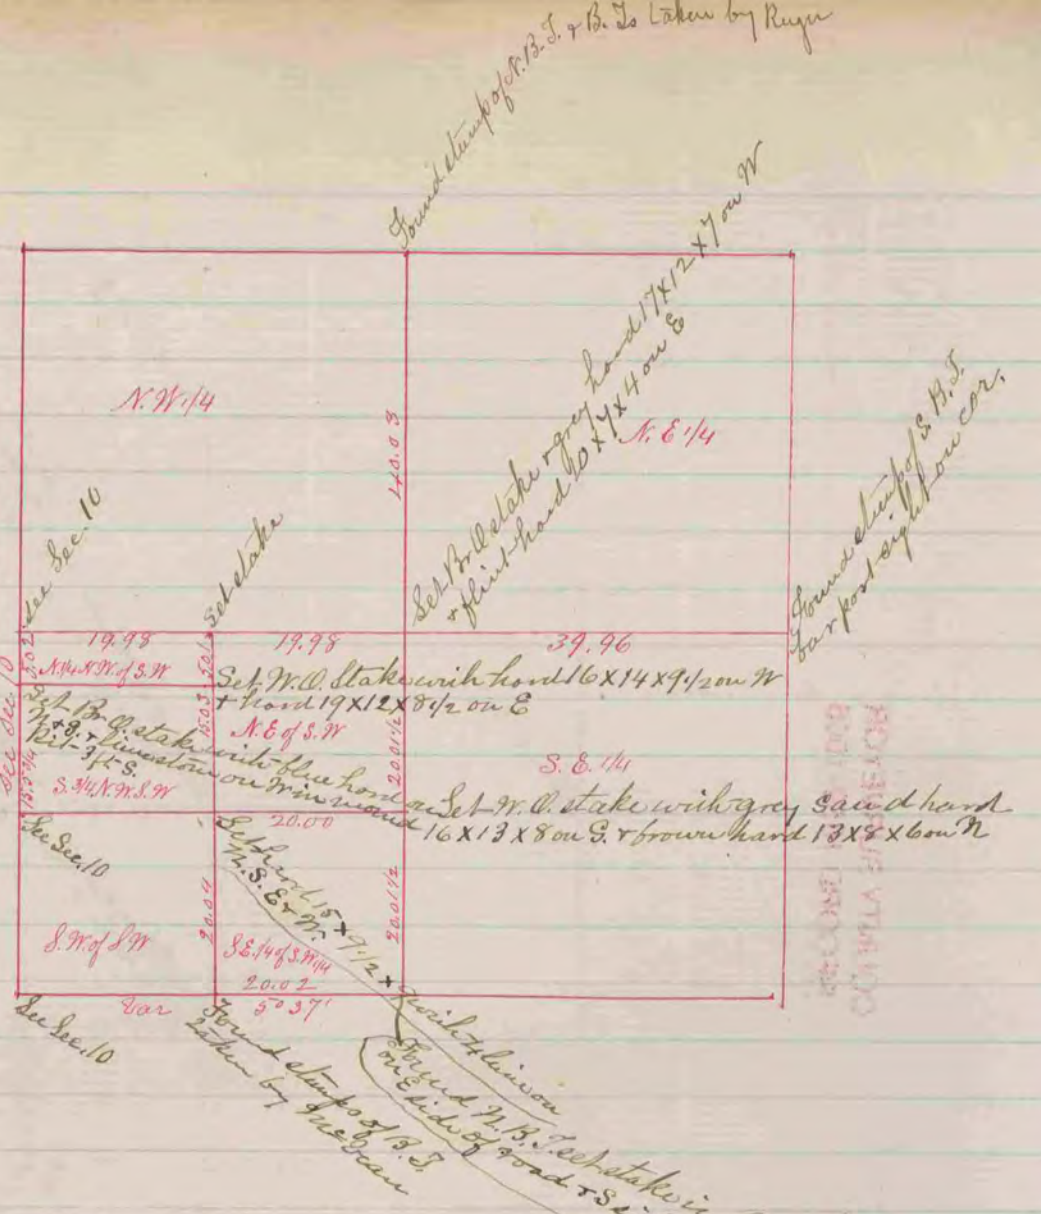

A Record & Plat of a Survey made on
Sec. 11. T. 1. R. 13. E. May 18. 1864, by S. D. Locke
Turtle Co. Surveyor

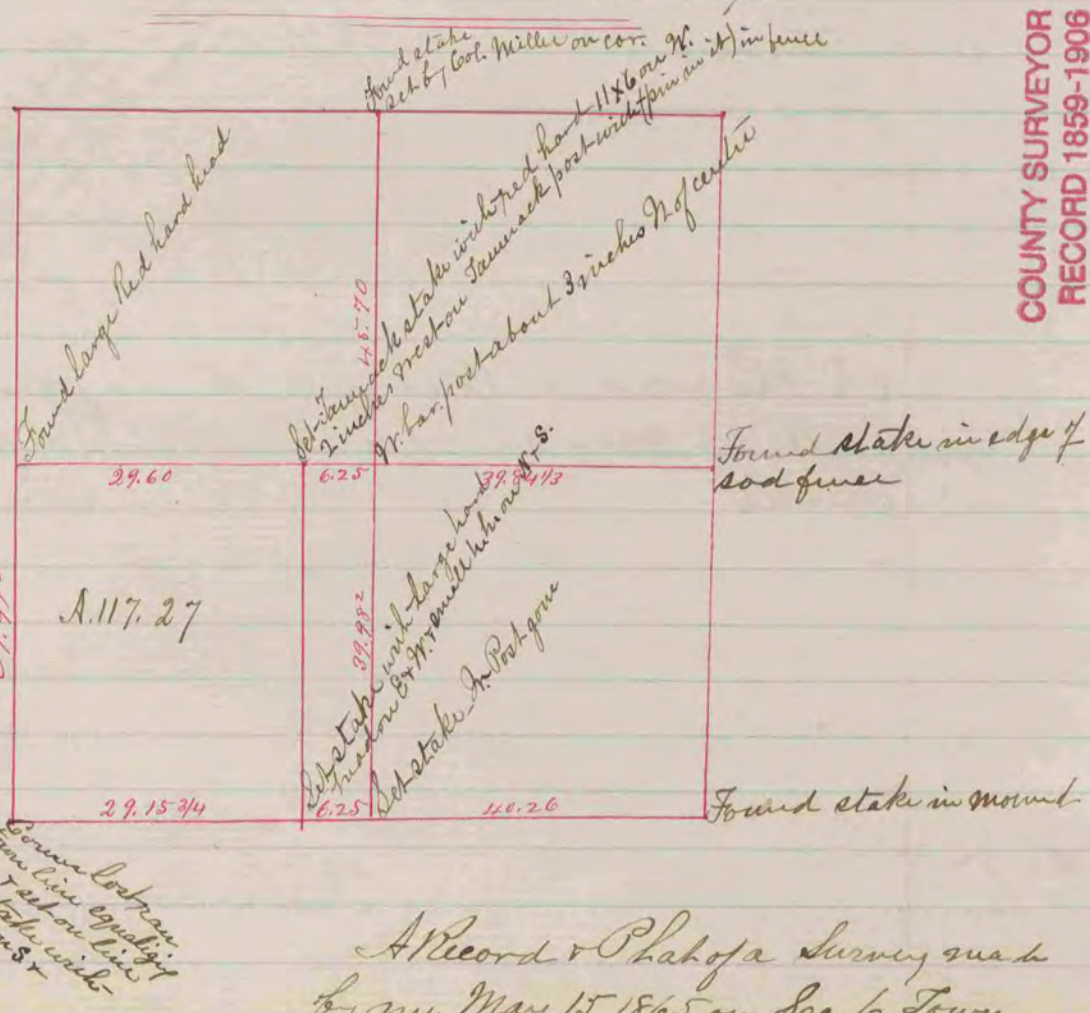

A Record & Plat of a Survey made by me May 15 1865 on Sec. 6 Town of Turtle S.D. Locke Co. Surveyor

COUNTY SURVEYOR
RECORD 1859-1906