COUNTY SURVEYOR
RECORD 1859-1906

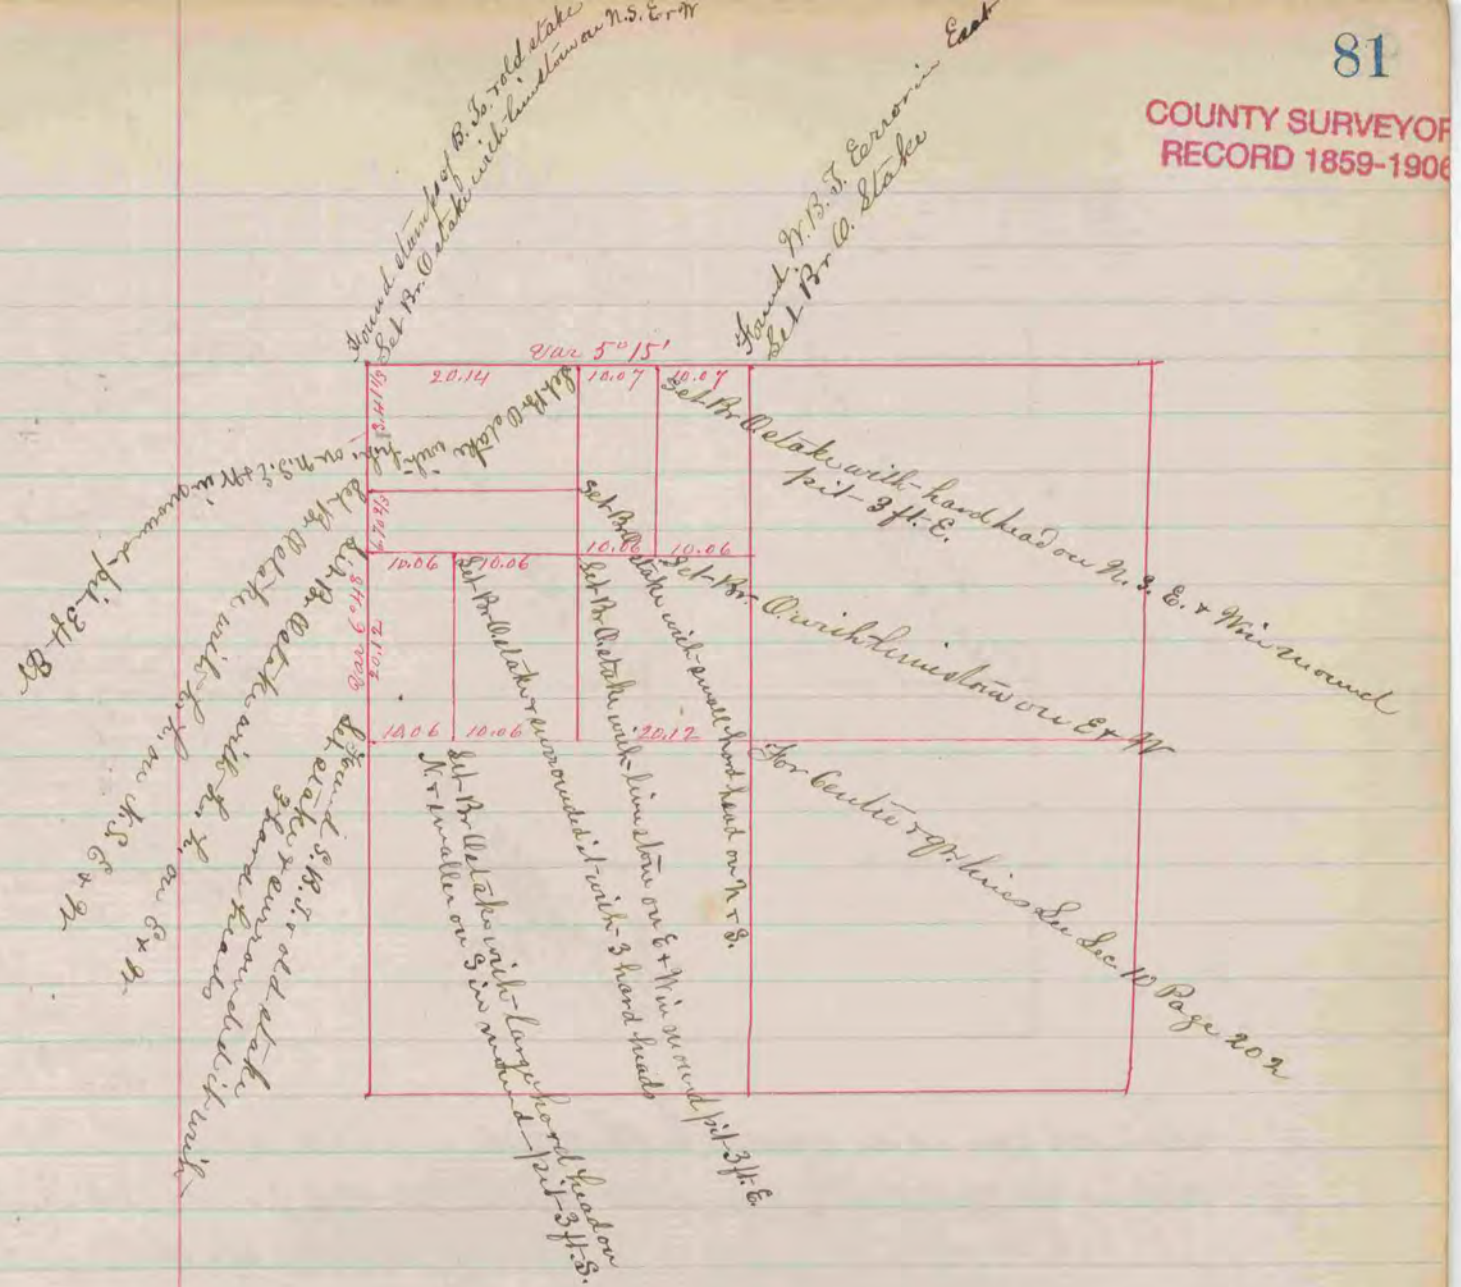
Found elm tree B. T. Set Br. Stake with hardwood
Found Pr. B. T. Set Br. Stake
Var 5° 15'
20.14
10.07
10.07
Set Br. Stake with hardwood on Pr. S. & Mi. mound
pit - 3 ft. E.