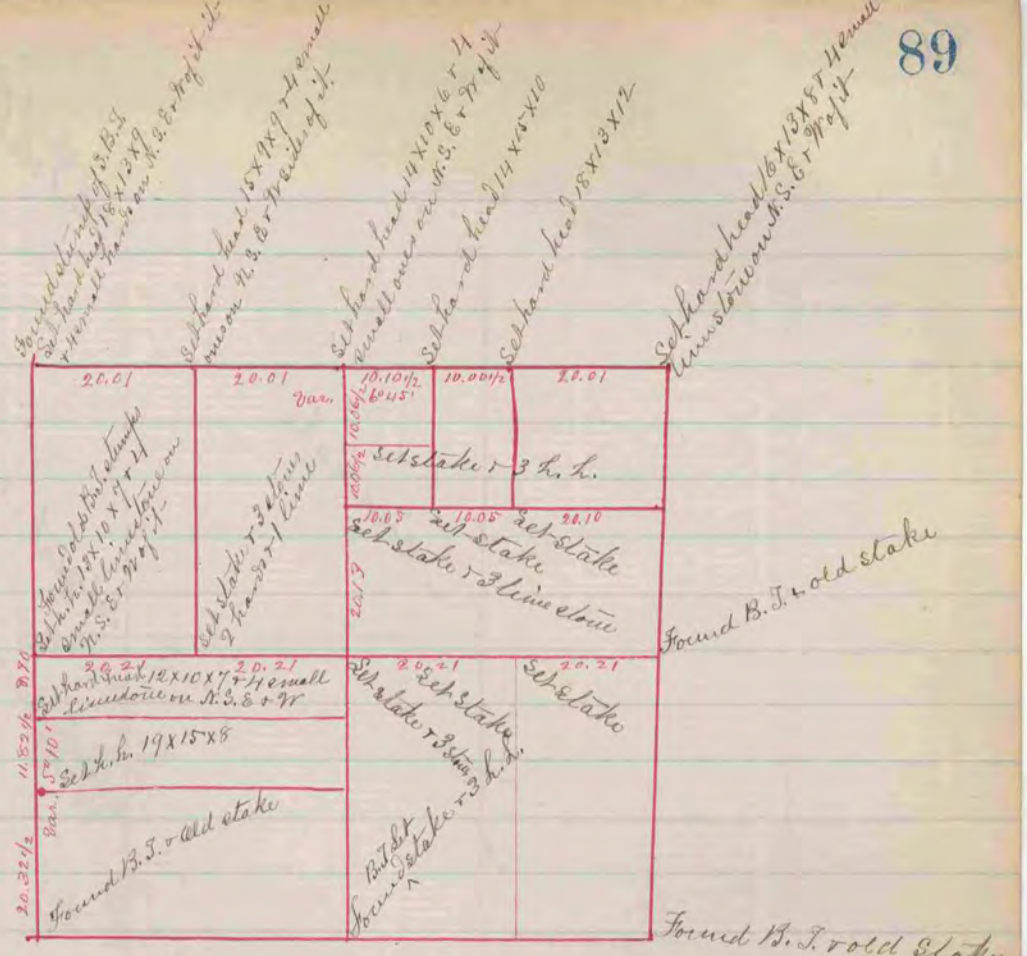

A Record + Plat of a survey made on Sec. 24. T. 1. R. 11. E. July 1. 1863. by S. D. Locke Co. Surveyor
Newark

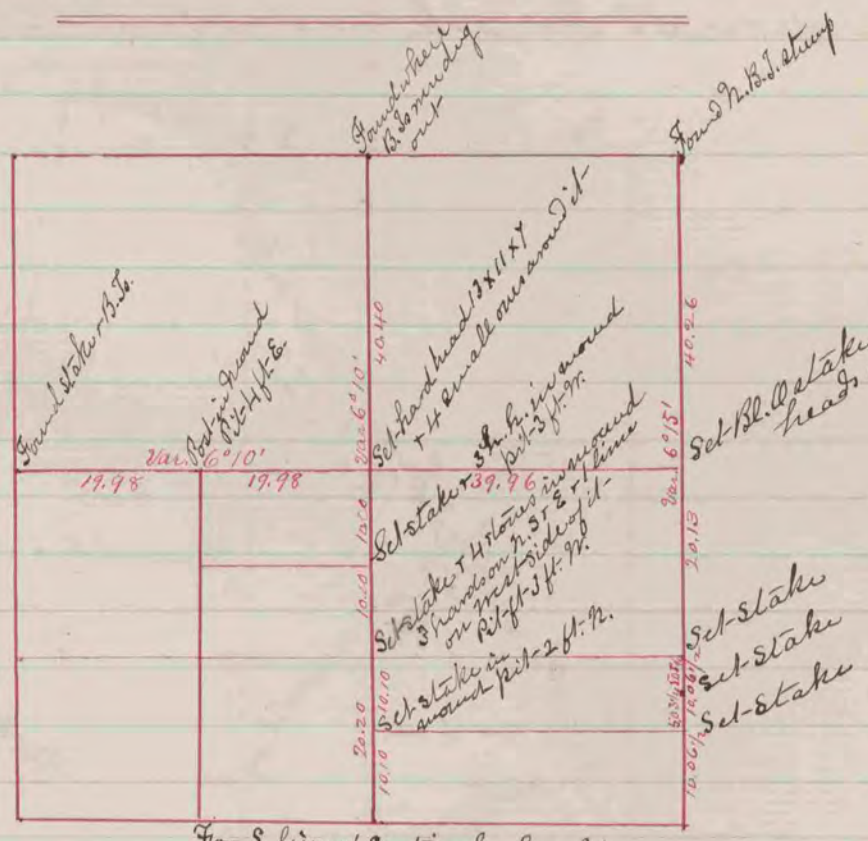

A Record + Plat of a Survey made July 2. 1863 on Sec. 13. T. 1. R. 11. E by S. D. Locke Co. Surveyor
Newark

COUNTY SURVEYOR
RECORD 1859-1906