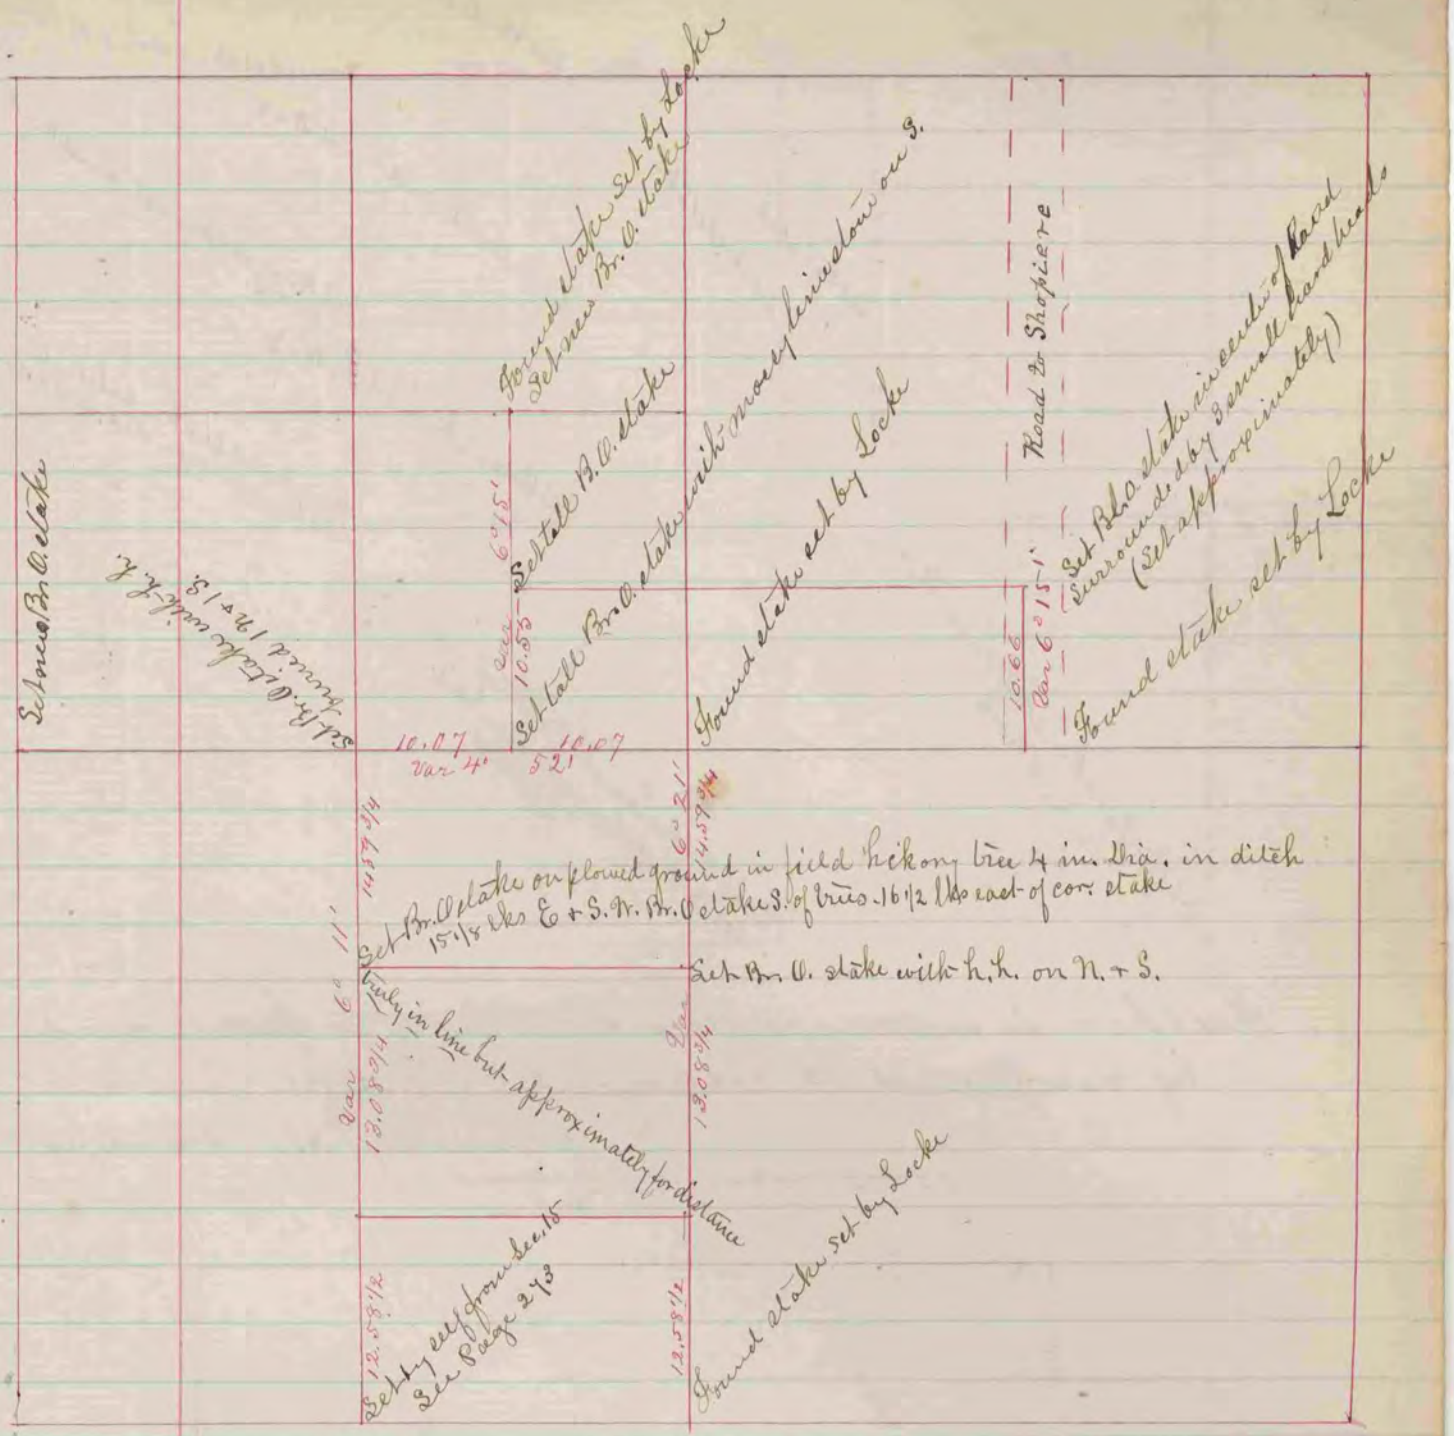

The above is a correct Record & Plat of a survey made by me Nov. 6. 10. 11 & 12 1868 on Sec. 10. T. 1. R. 13 E. Turtle

R. K. Lee Dep. Co. Surveyor

COUNTY SURVEYOR
RECORD 1859-1906