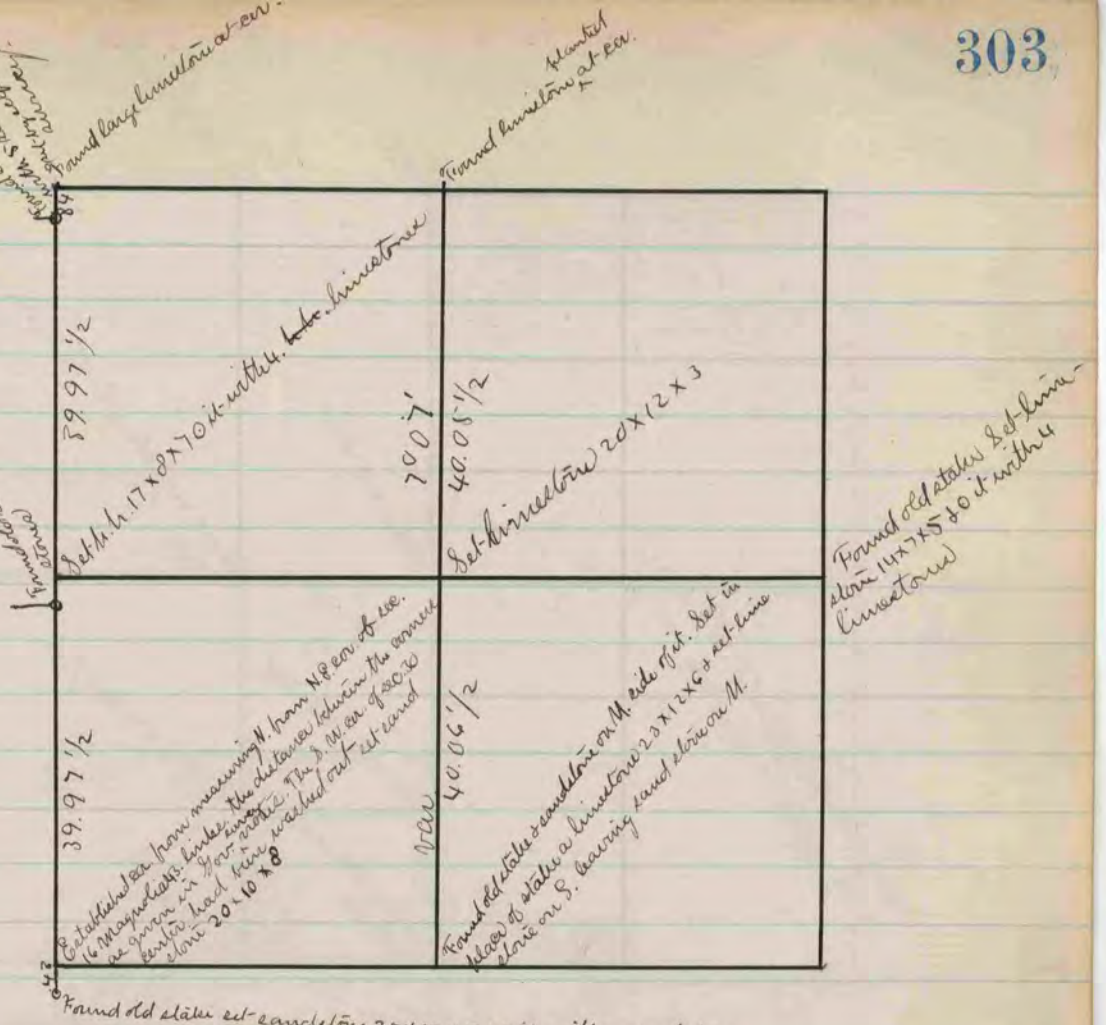
Found large limestone at cor.
Found limestone at cor.
Found old stake & set-lime-stone 14x7x5 & 0 it with 4 limestones
Found old stake & set-lime-stone 25x12x5 & 0 it with 4 candlestones
Set h. h. 17x8x7 0 it-with 4 lime-stones
Set-limestone 20x12x3
Found old stake & candlestone on N. side of it. Set in base of stake a limestone 23x12x6 & set-lime stone on S. bearing sand stone on N.
Established cor. from measuring N. from N.E. cor. of sec. (16 Magnolia) by links. The distance between the corners as given in your notice. The S.W. cor. of sec. 30 Centre had been washed out set sand stone 20x10x8
Found old stake & set-limestone 12x12x5 & 0 it with 4 lime-stones
Found old stakes