COUNTY SURVEYOR
RECORD 1 1851-1869



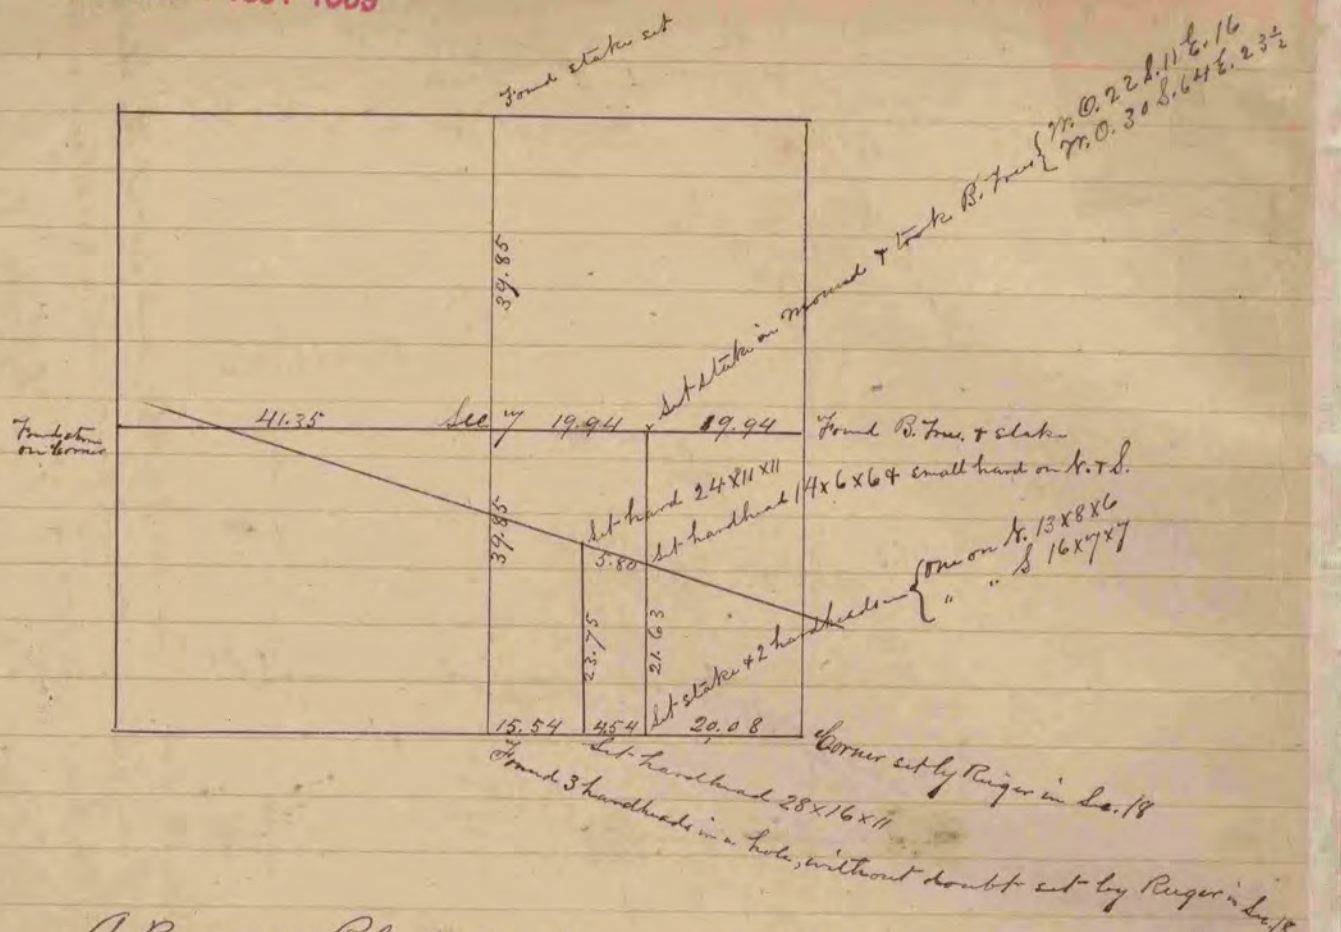


A Record & Plat of a Survey made Nov. 17 & 18, 1863 on Sec. 7 T. 4 N. R. 10 E by S. D. Locke County Surveyor Rock Co. Wis.

Union

---

A Record & Plat of a Survey made Dec 9, 1863, on Sec. 3, T. 3 N. R. 10 E. by S. D. Locke County Surveyor in and for Rock County Wis.
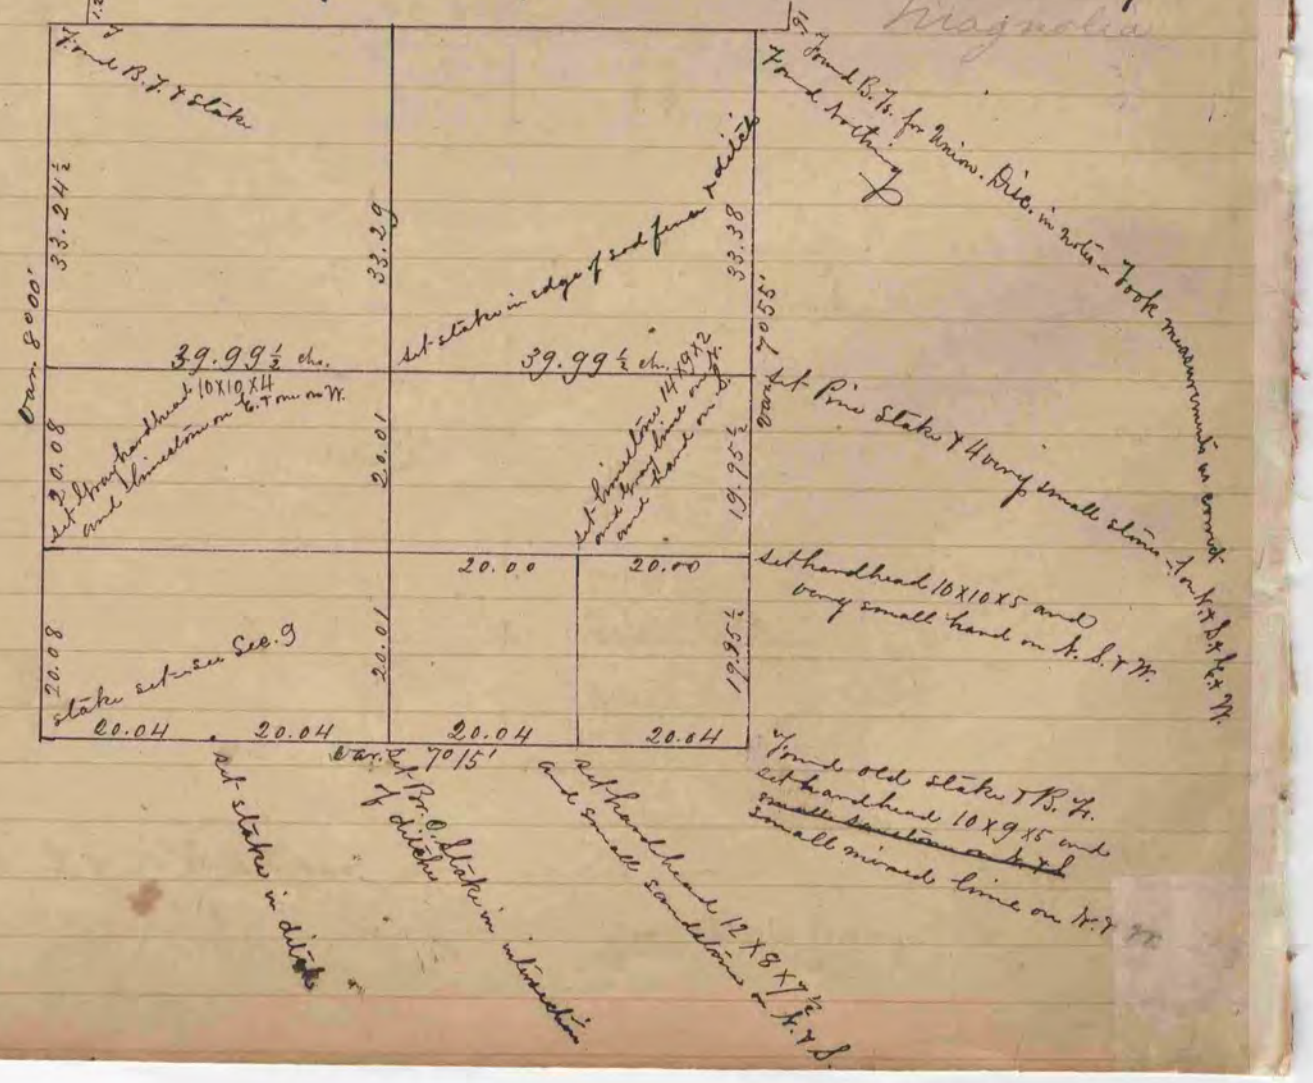
Magnolia