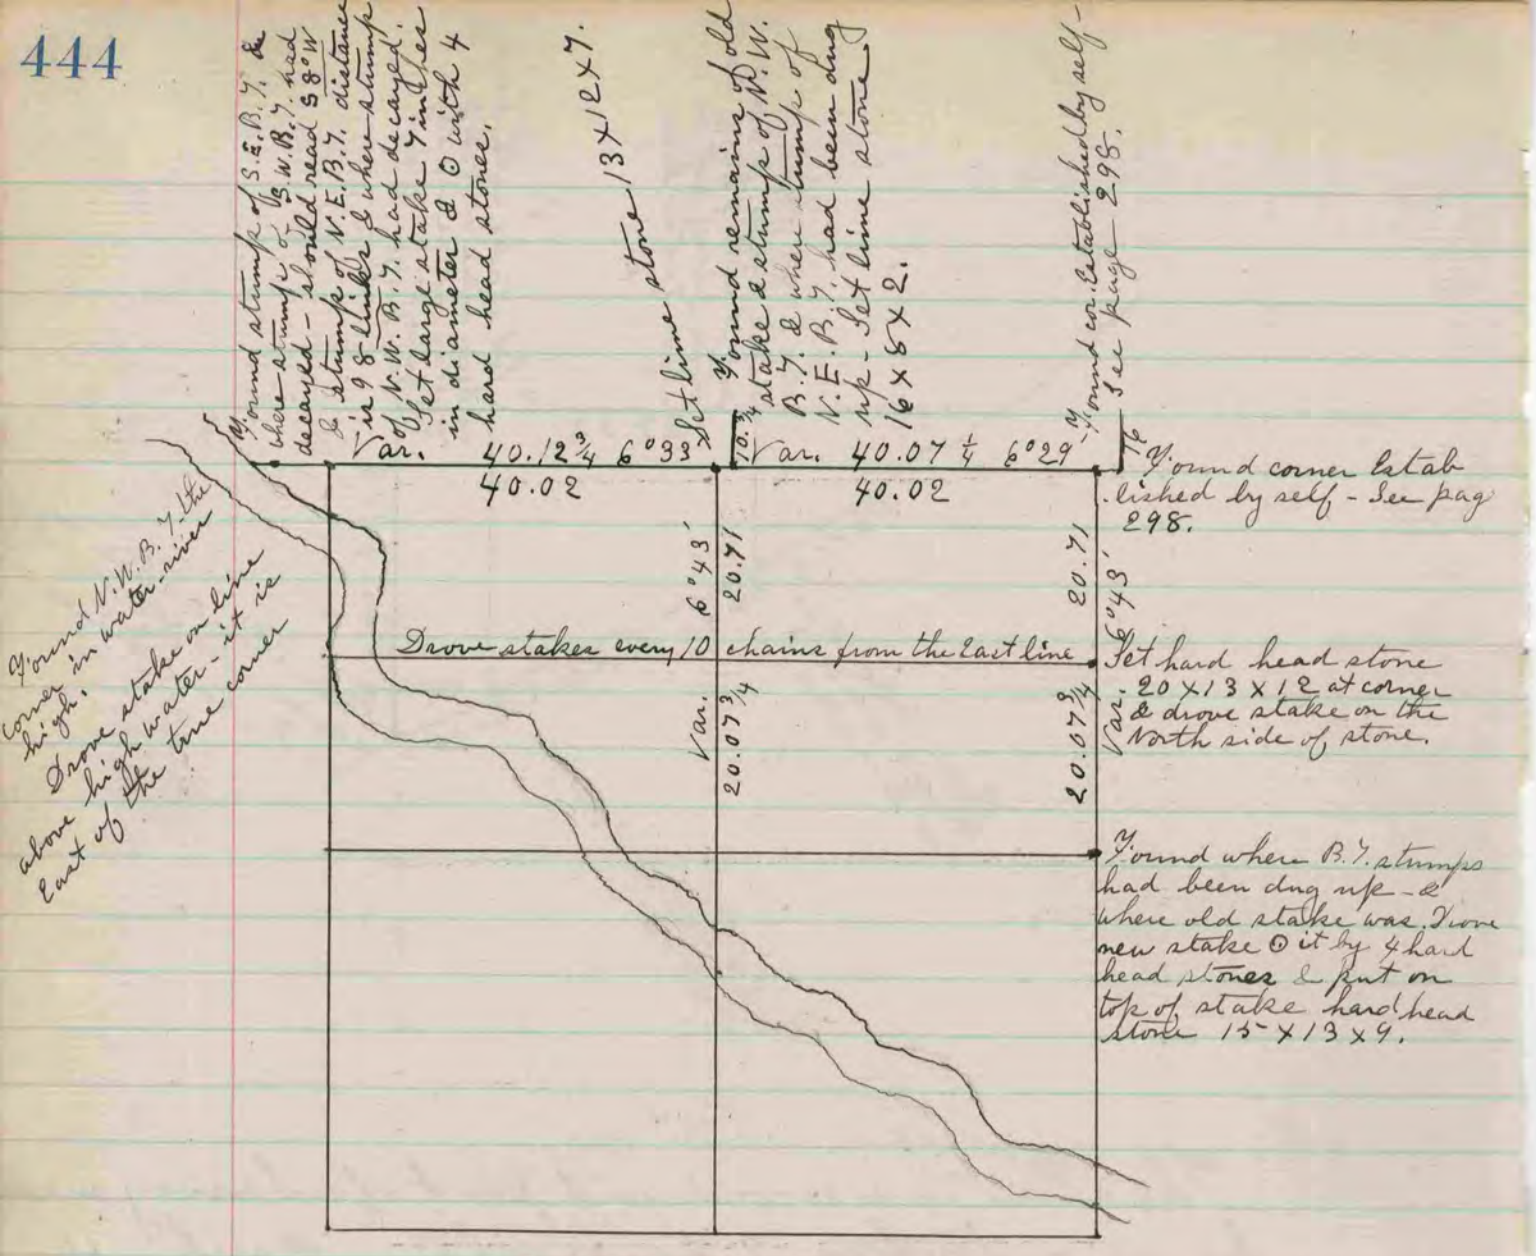

The above is a record & plat of a Survey made by me on Sections 5 & 6 Janesville May 29 & 30 - 1876

Edward Ruger
County Surveyor.

COUNTY SURVEYOR
RECORD 1859-1906