COUNTY SURVEYOR
RECORD 1 1851-1869

A Record and plat of a Survey made on Sec 8 Town three Range [illegible]

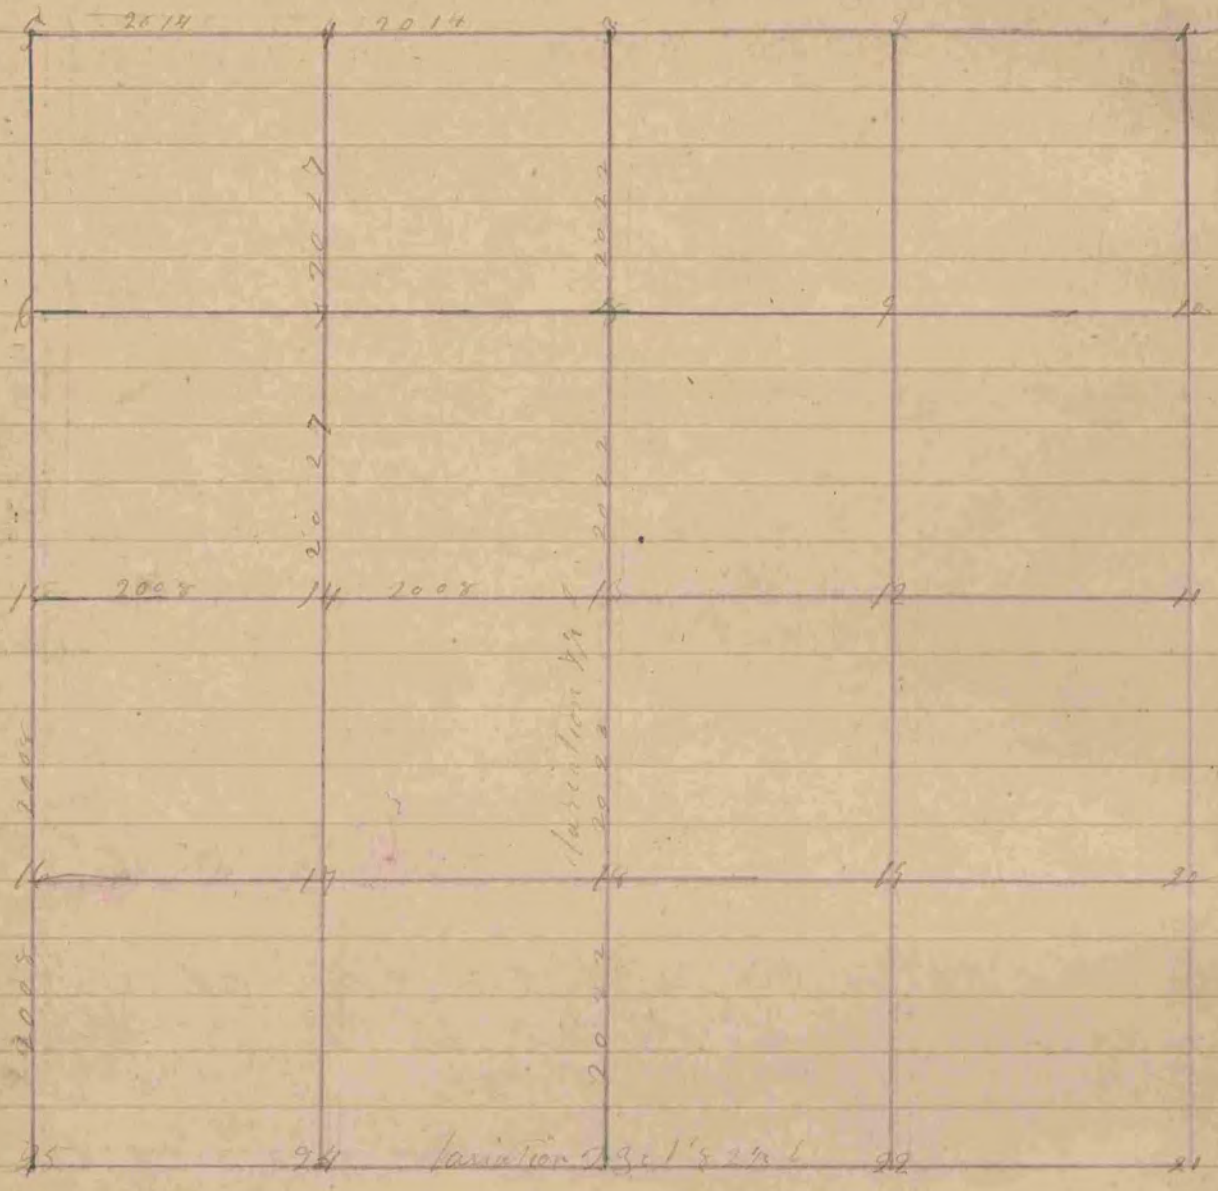

Key 13 Centre of Sec buried Stone no bearings in the centre of road
4 Wit to St to Sec O 14 S 31 E 61
[illegible]
18 W O 24 N 64½ W 75 E
24 S 57½ E 54 W
17 Sec O 8 S 72½ W 40
W O 2 S 78 E 45 W

The Above Survey was made the 20th of Dec 1855.
Joseph Church County Surveyor
of Rock County Wis