COUNTY SURVEYOR
RECORD 1859-1906

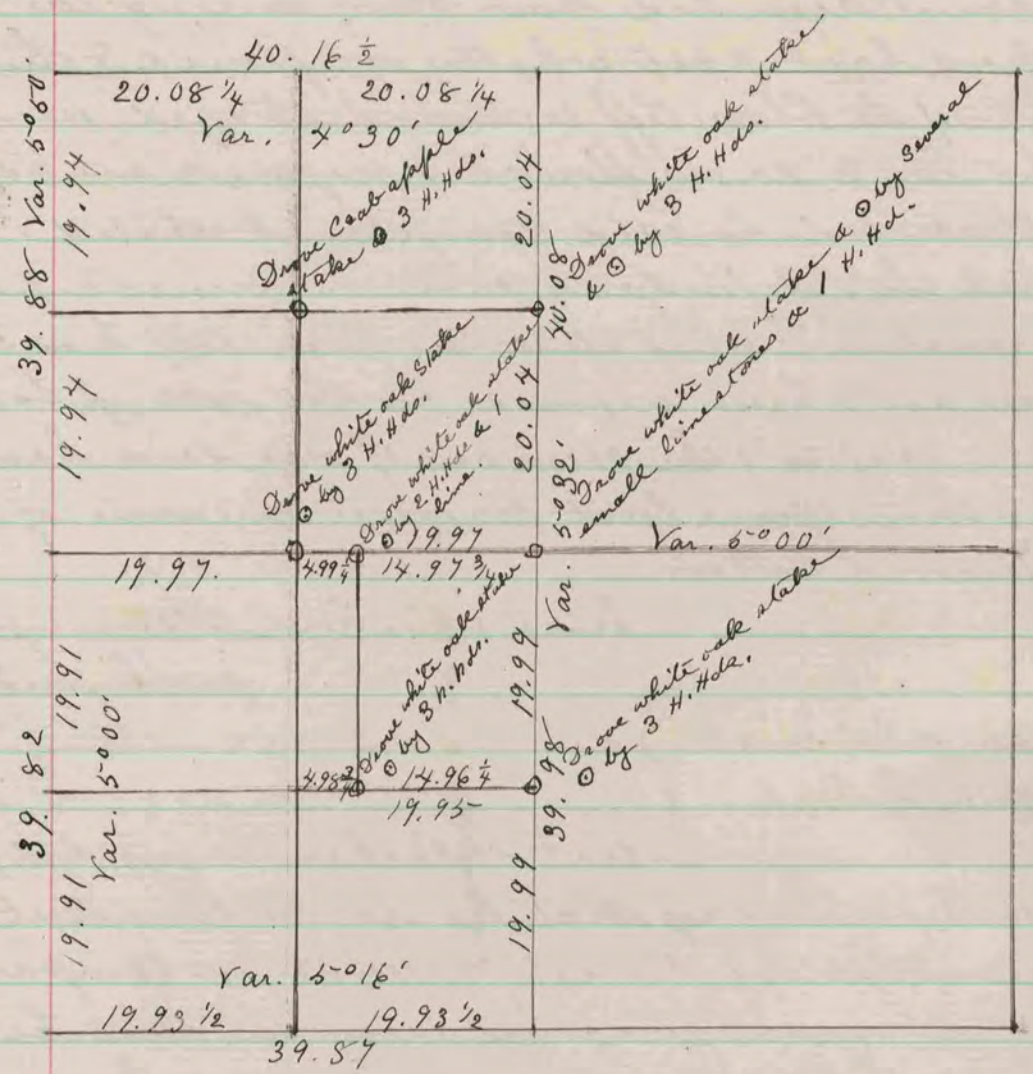


The above is a record & plat of a Survey made by me Sept 8th & 9th 1881 on Section 12 Newark

R. K. Lee
County Surveyor.