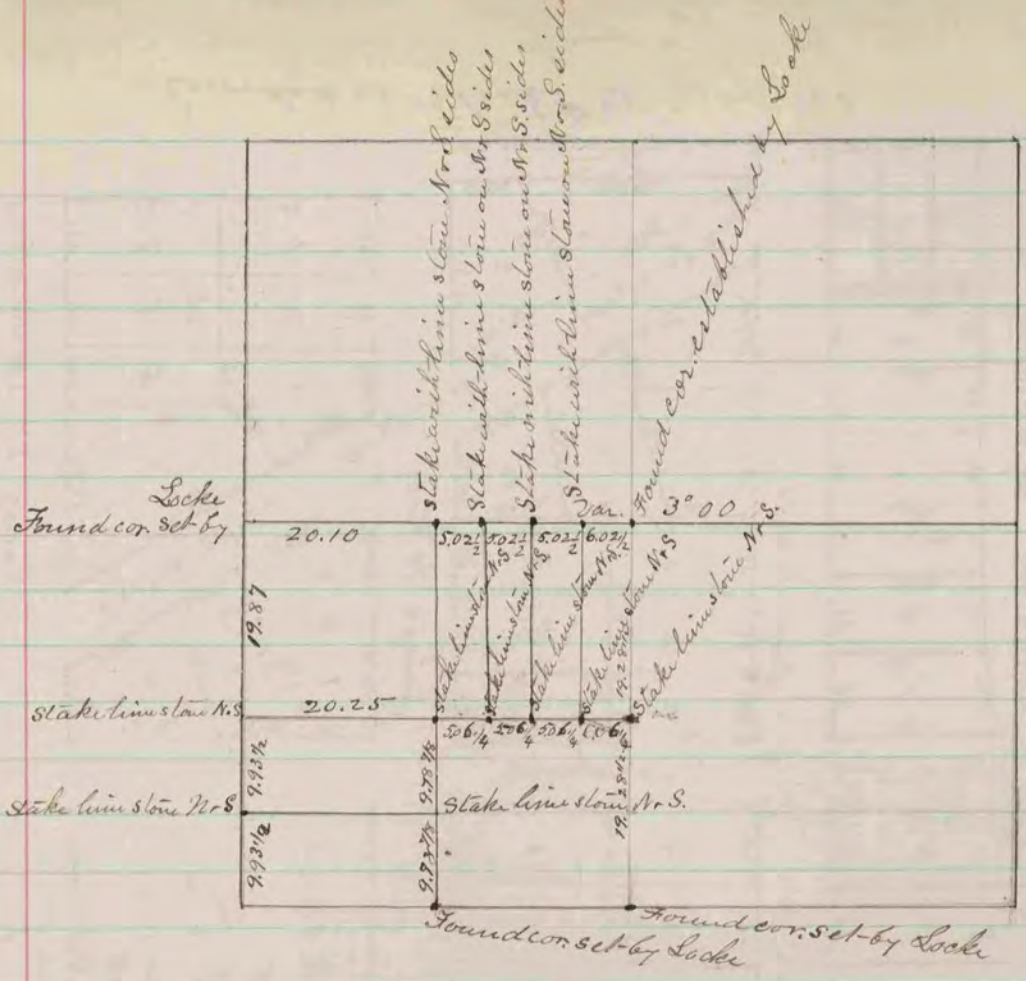

The above is a correct Record & Plat of a Survey made by me May 19-1869 on Sec. 1 Spring Valley

R. K. Lee

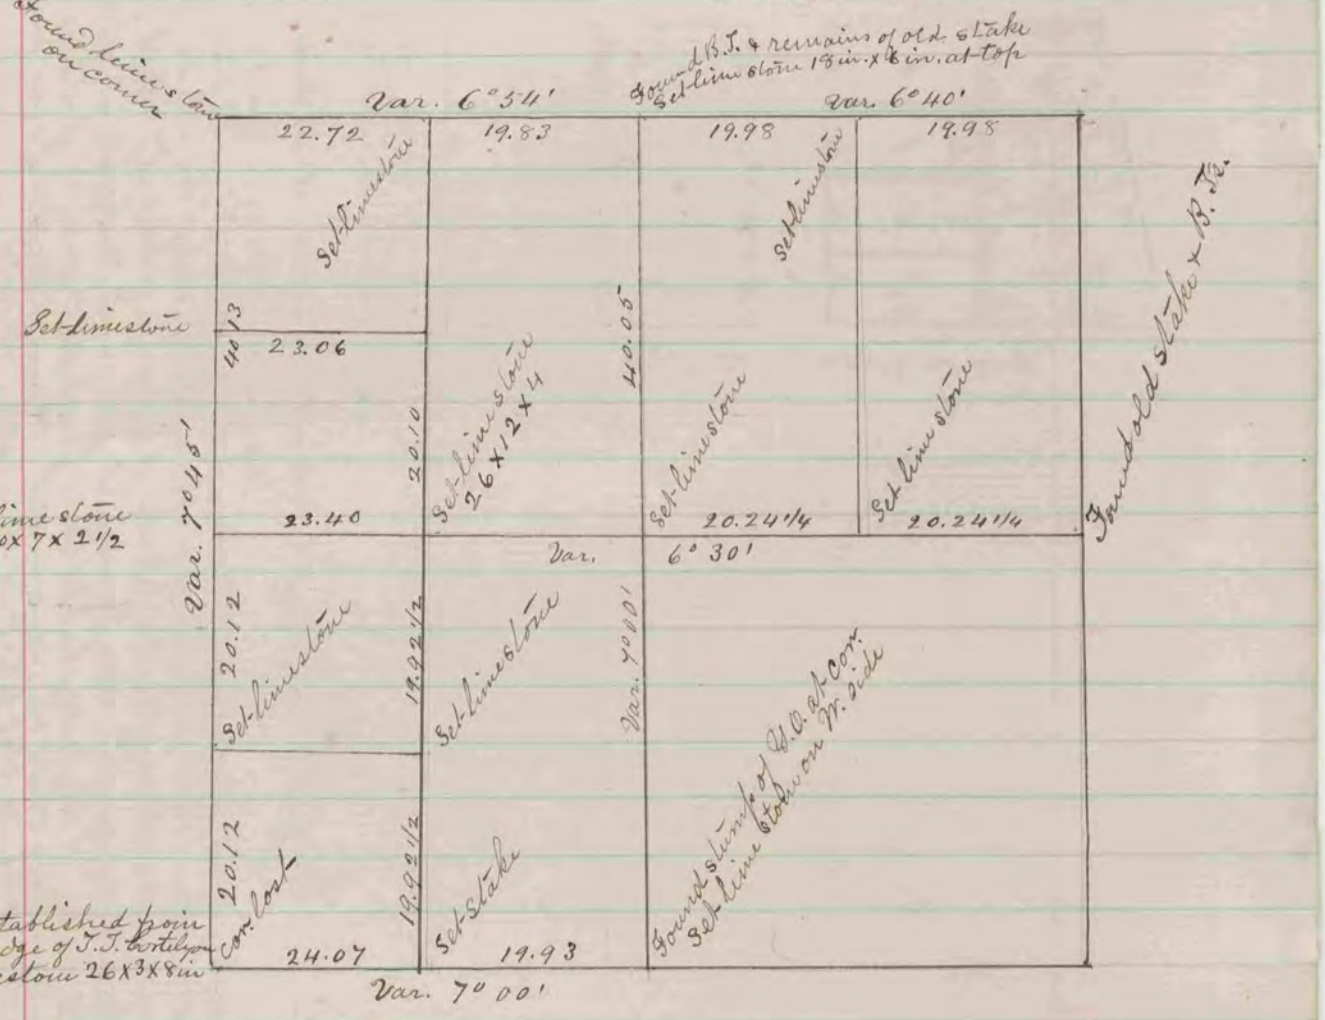

The above is a correct Record & Plat of a Survey made by me on Sec. 30. T. 2. R. 10 Spring Valley June 26 & 27 1869 R. K. Lee Dep. Co. Surveyor & April 4-5 1877