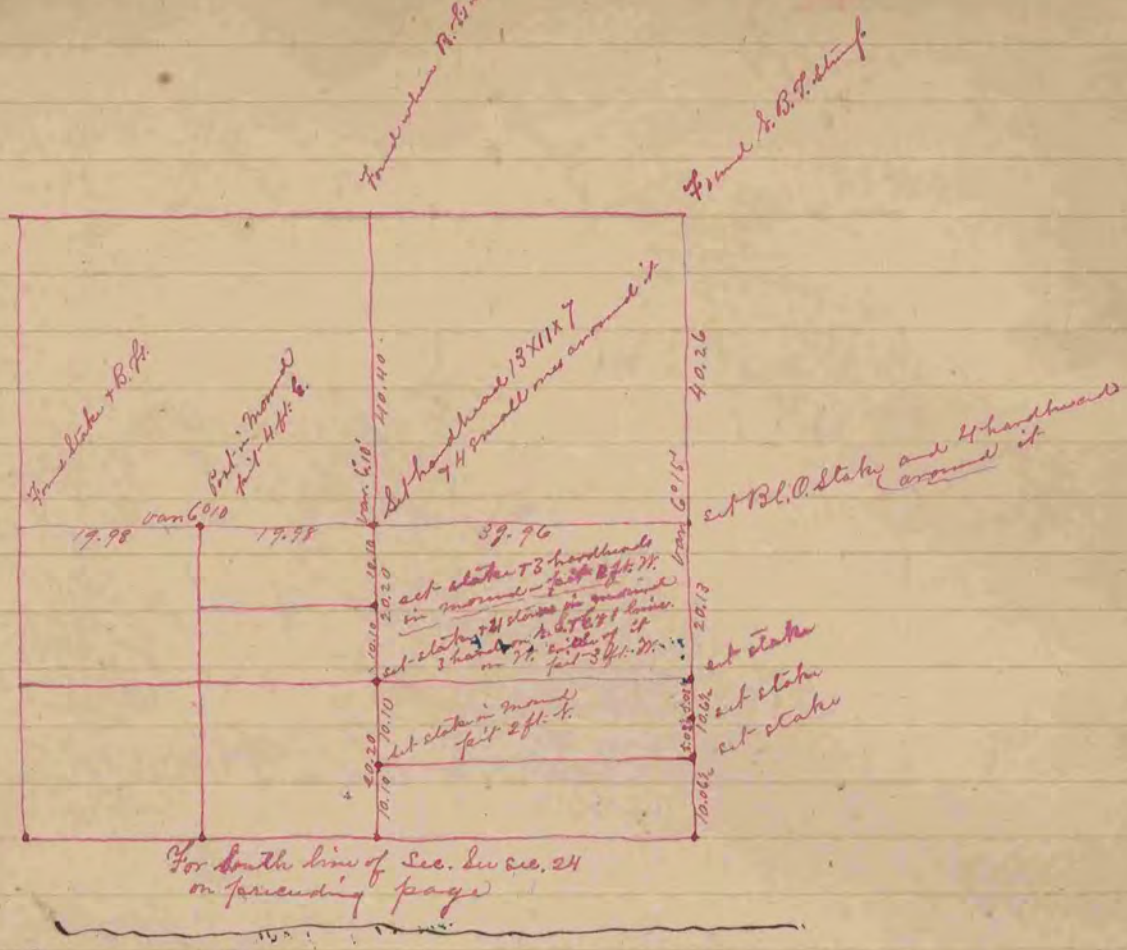

A Record Plat of a Survey made July 2, 1863 on Sec. 13 T. 1 R. 11 E. by S.D. Locke, County Surveyor in and for Rock County Wis.
Newark

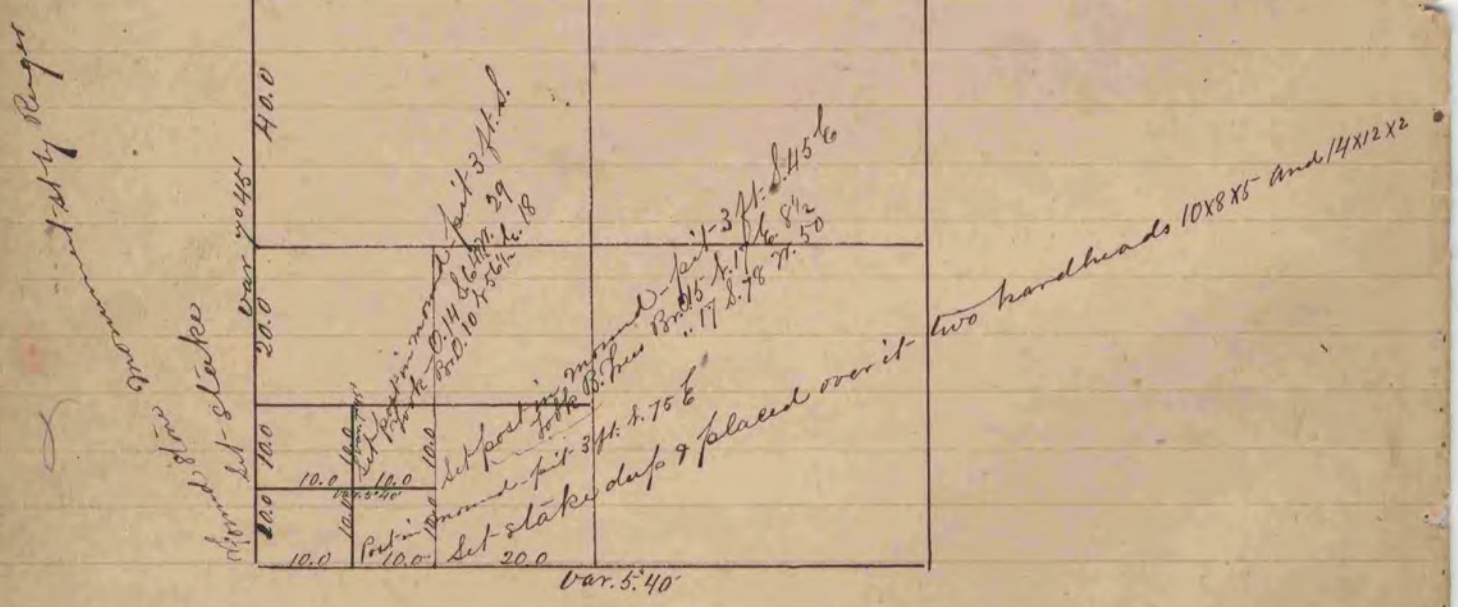

A record & Plat of Survey made on Sec. 9, T. 3, R. 13 E. July 15, 1863 by S.D. Locke County Surveyor in and for Rock Co. Wis.
The above was only an Approximate Survey - S.D. Locke
See page 212 Harmony

COUNTY SURVEYOR
RECORD 1 1851-1869