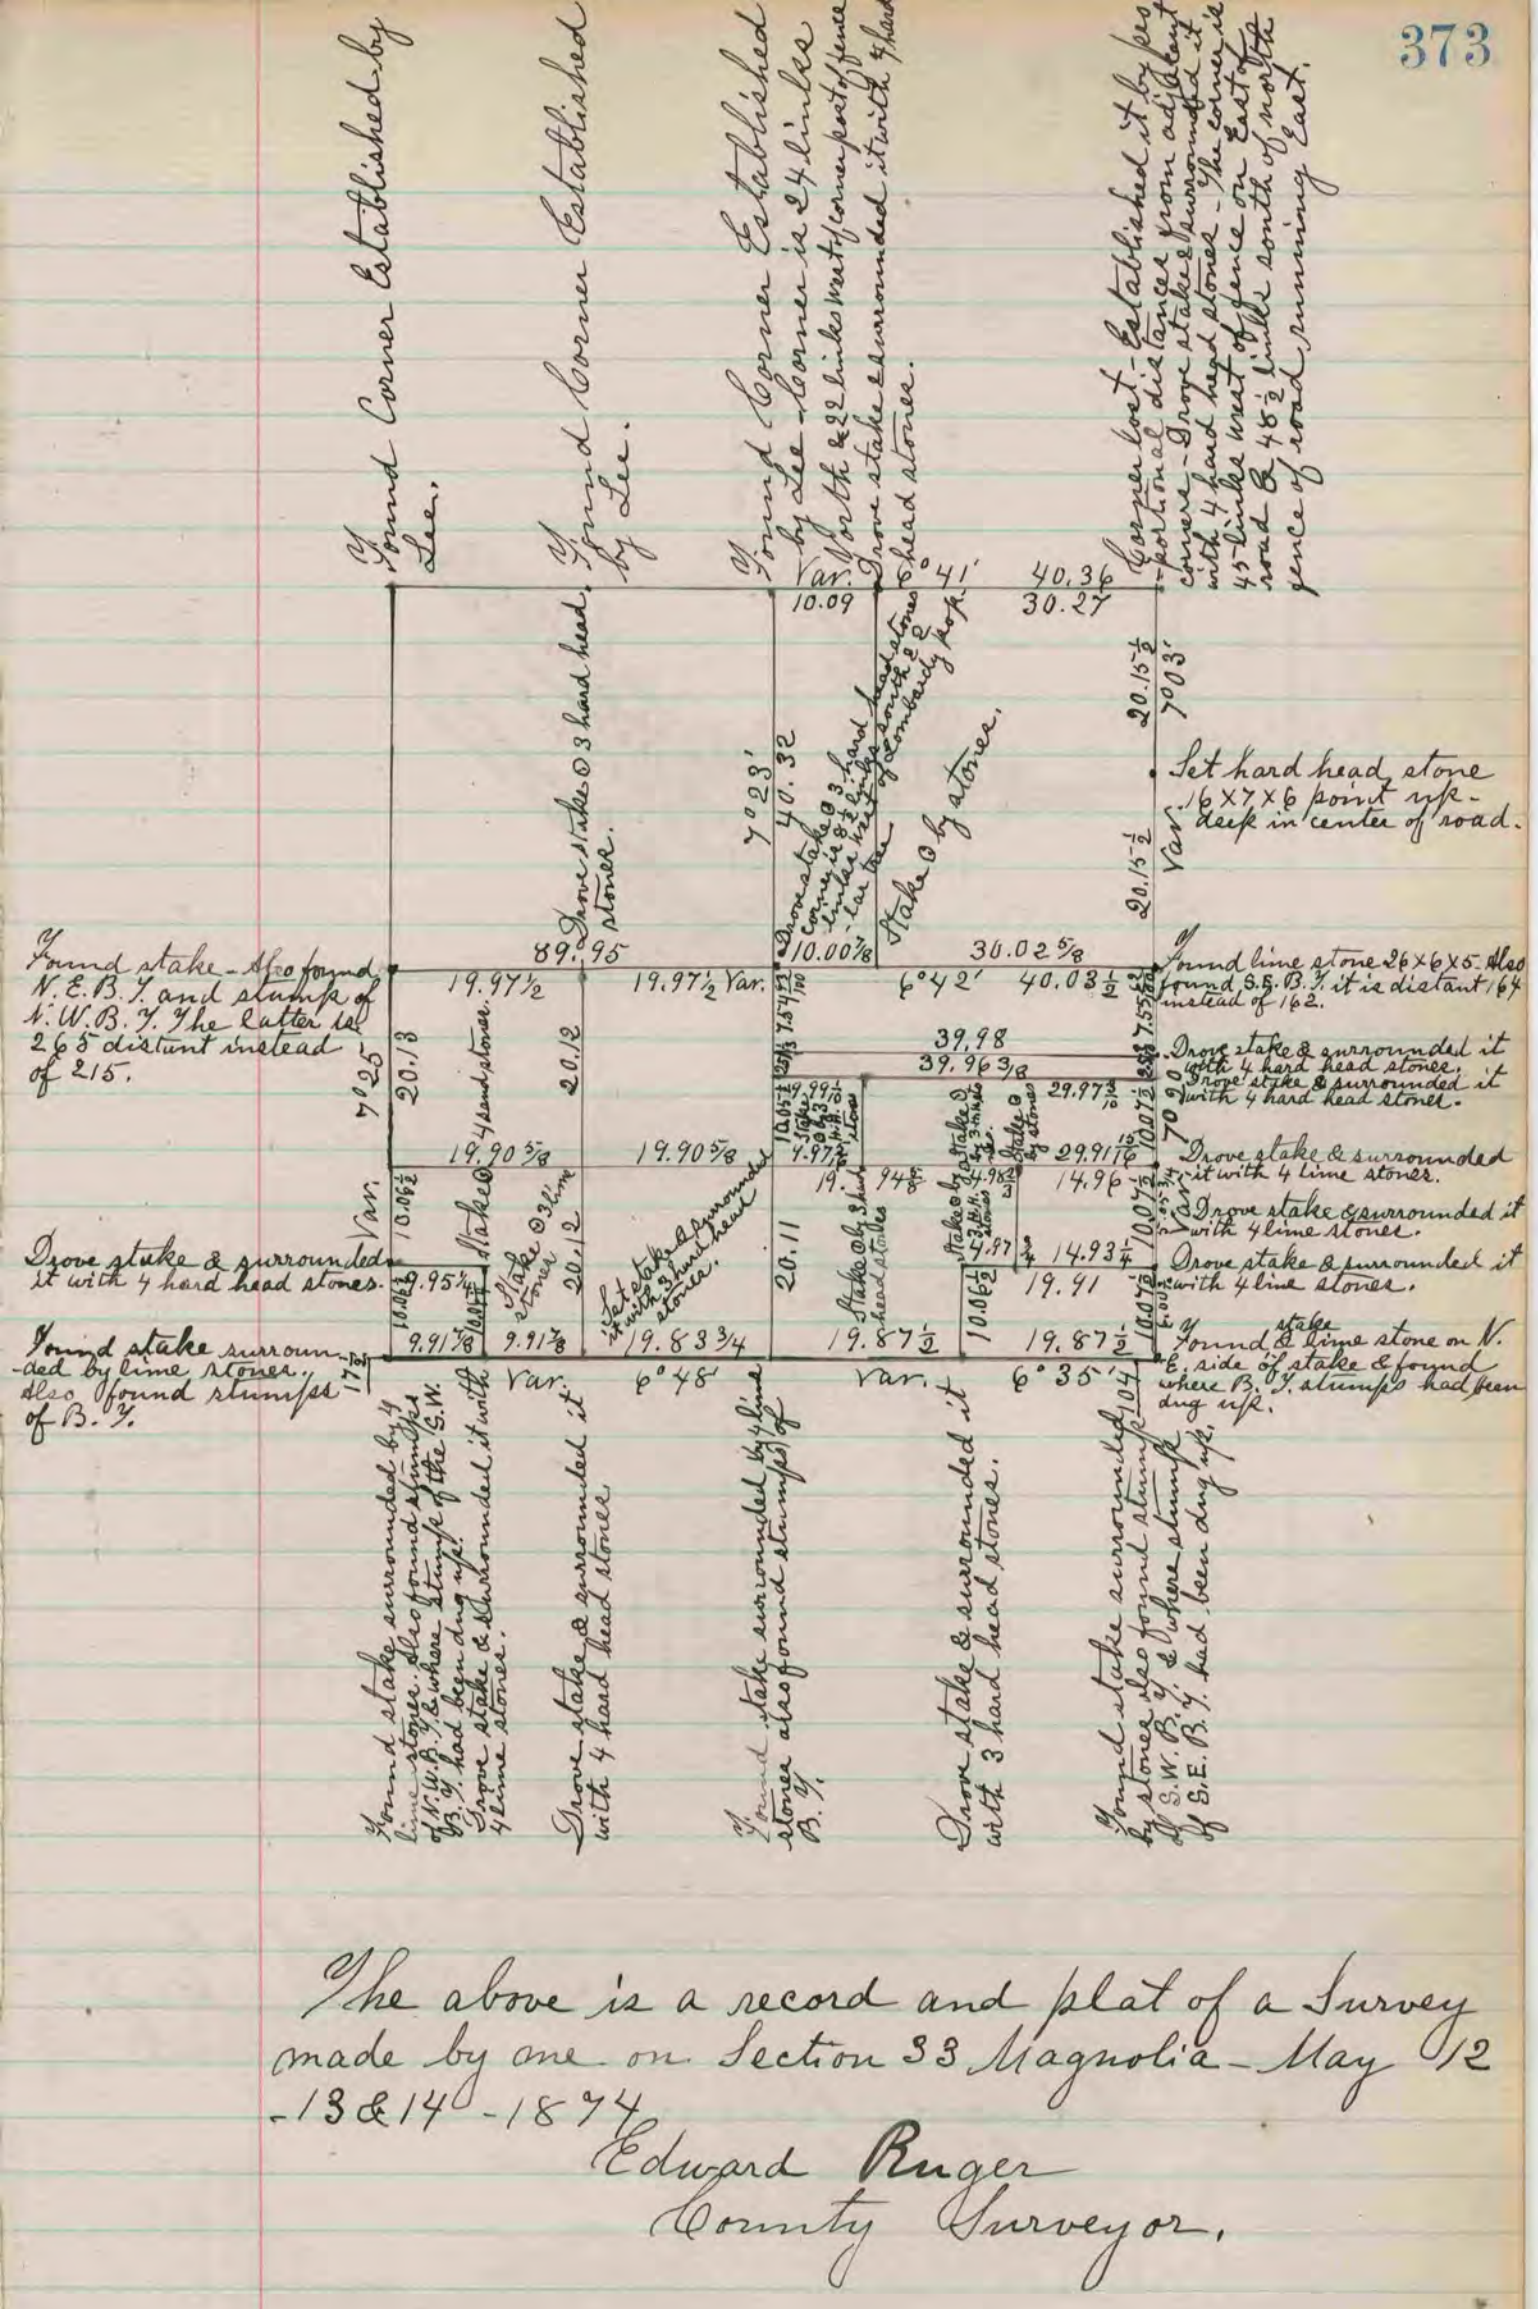

The above is a record and plat of a Survey made by me on Section 33 Magnolia - May 12 -13 & 14 - 1874

Edward Ruger
County Surveyor.

COUNTY SURVEYOR
RECORD 1859-1906