COUNTY SURVEYOR
RECORD 1859-1906 333
COUNTY SURVEYO
RECORD 1859-19

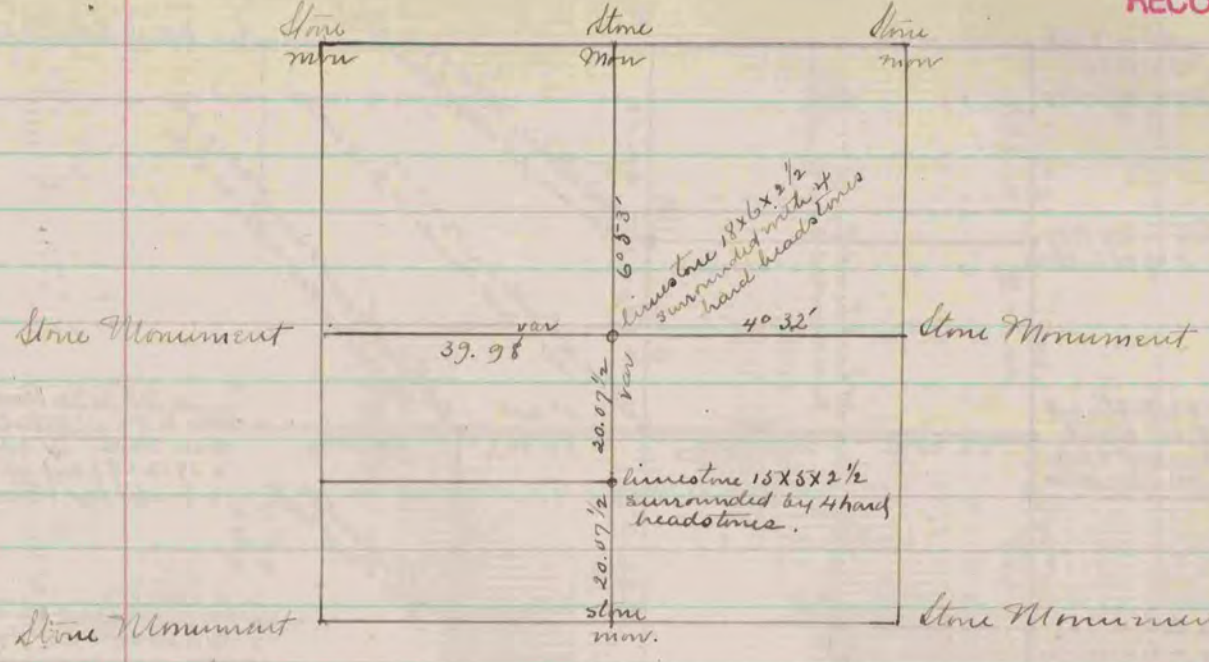

The above is a record & plat of a survey made on Sec. 33 Hilton, Sept 25th 1871, by Edward Ruger- Co. Surveyor.

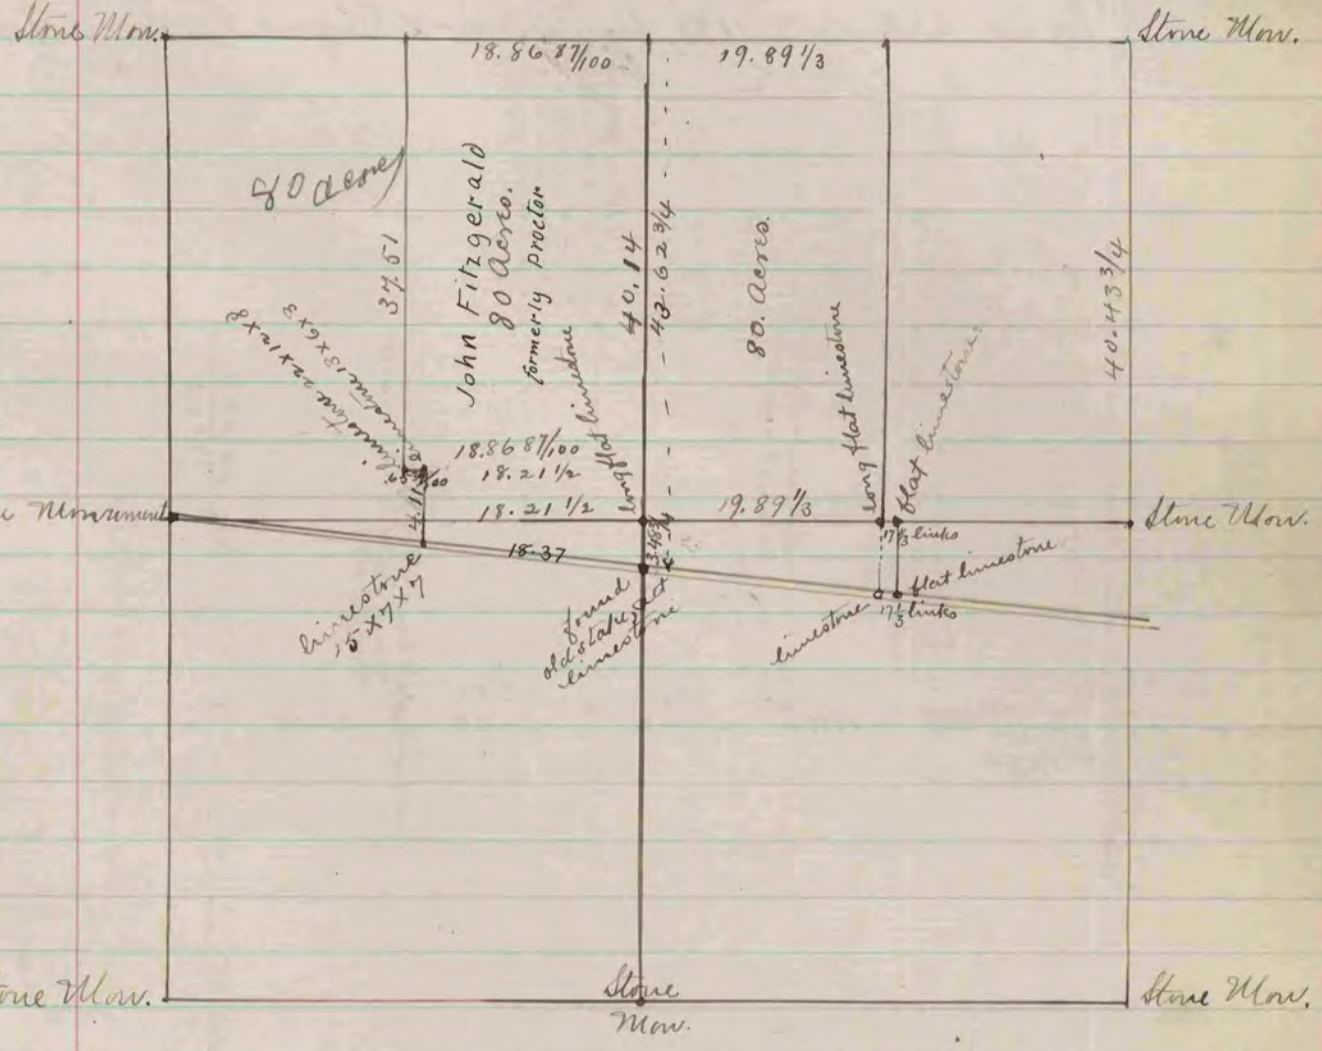

The above is a record & plat of survey made on Sec. 3. La Prairie Sept 29 & 30. 1871 and June 25. 1883 by

Edward Ruger
County Surveyor.

March 30. 1907. re-traced the John Fitzgerald tract