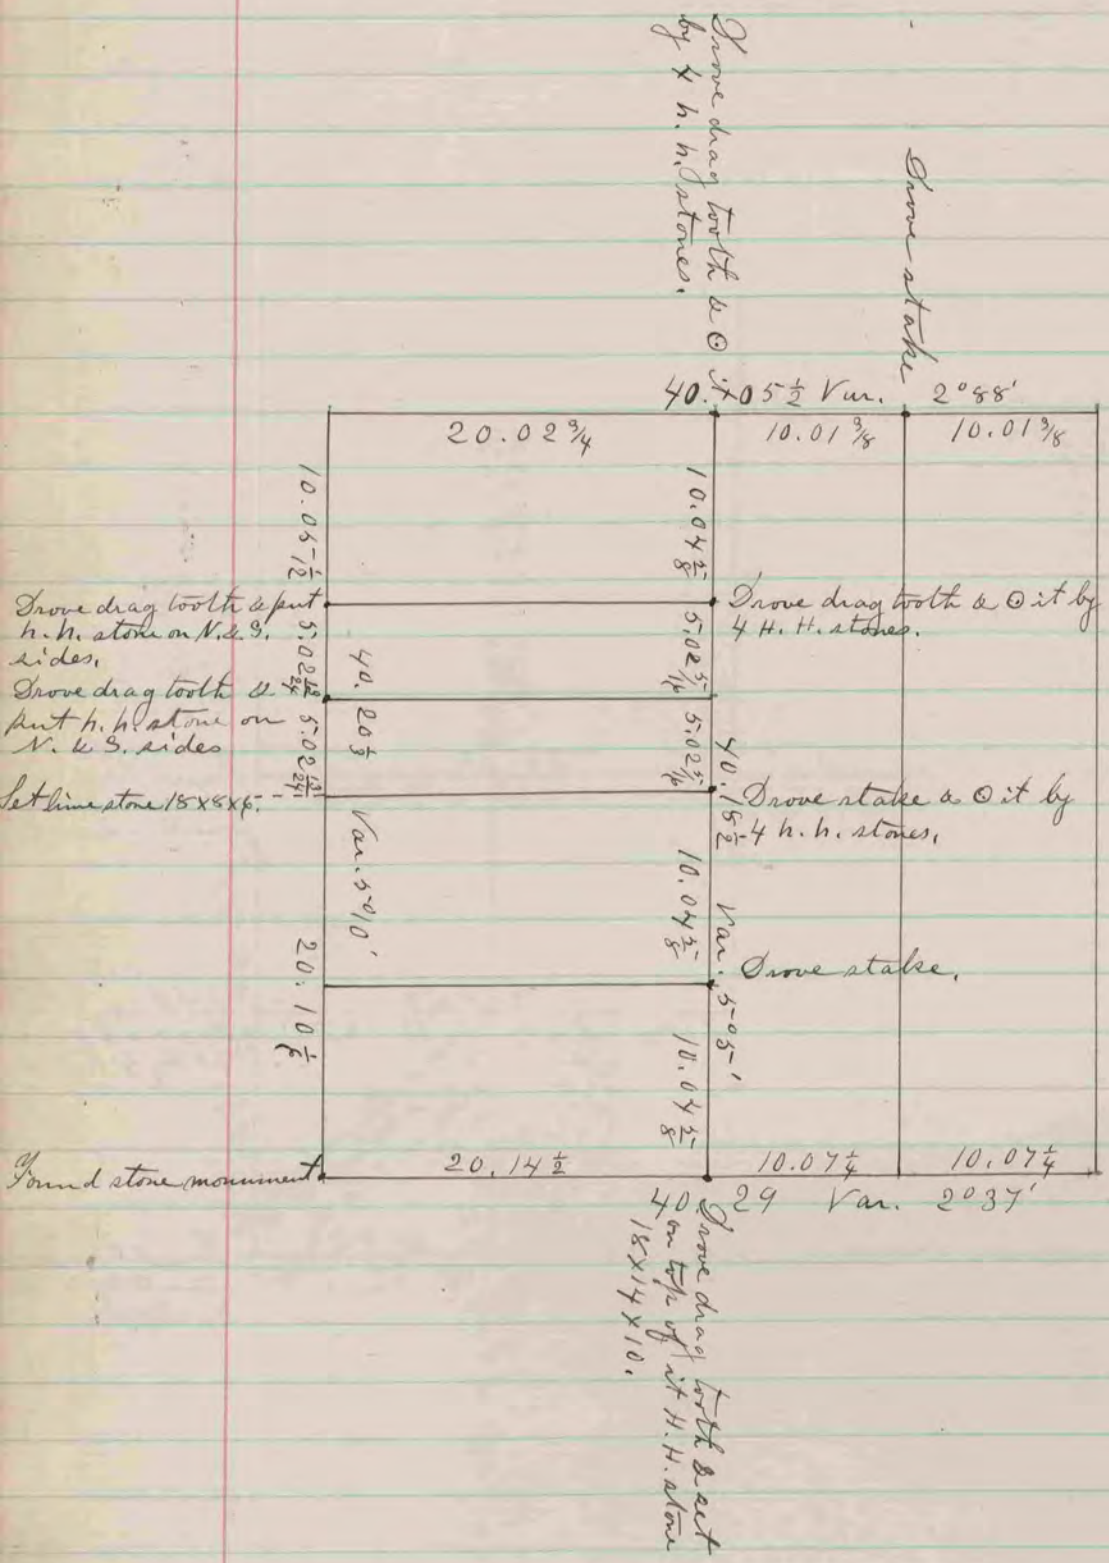

The above is a record and plat of a survey made by me on the S. W. ¼ of Sec. 14 - Harmony - Nov - 15 - 1886

Edward Ruger
County Surveyor.

COUNTY SURVEYOR
RECORD 1859-1906