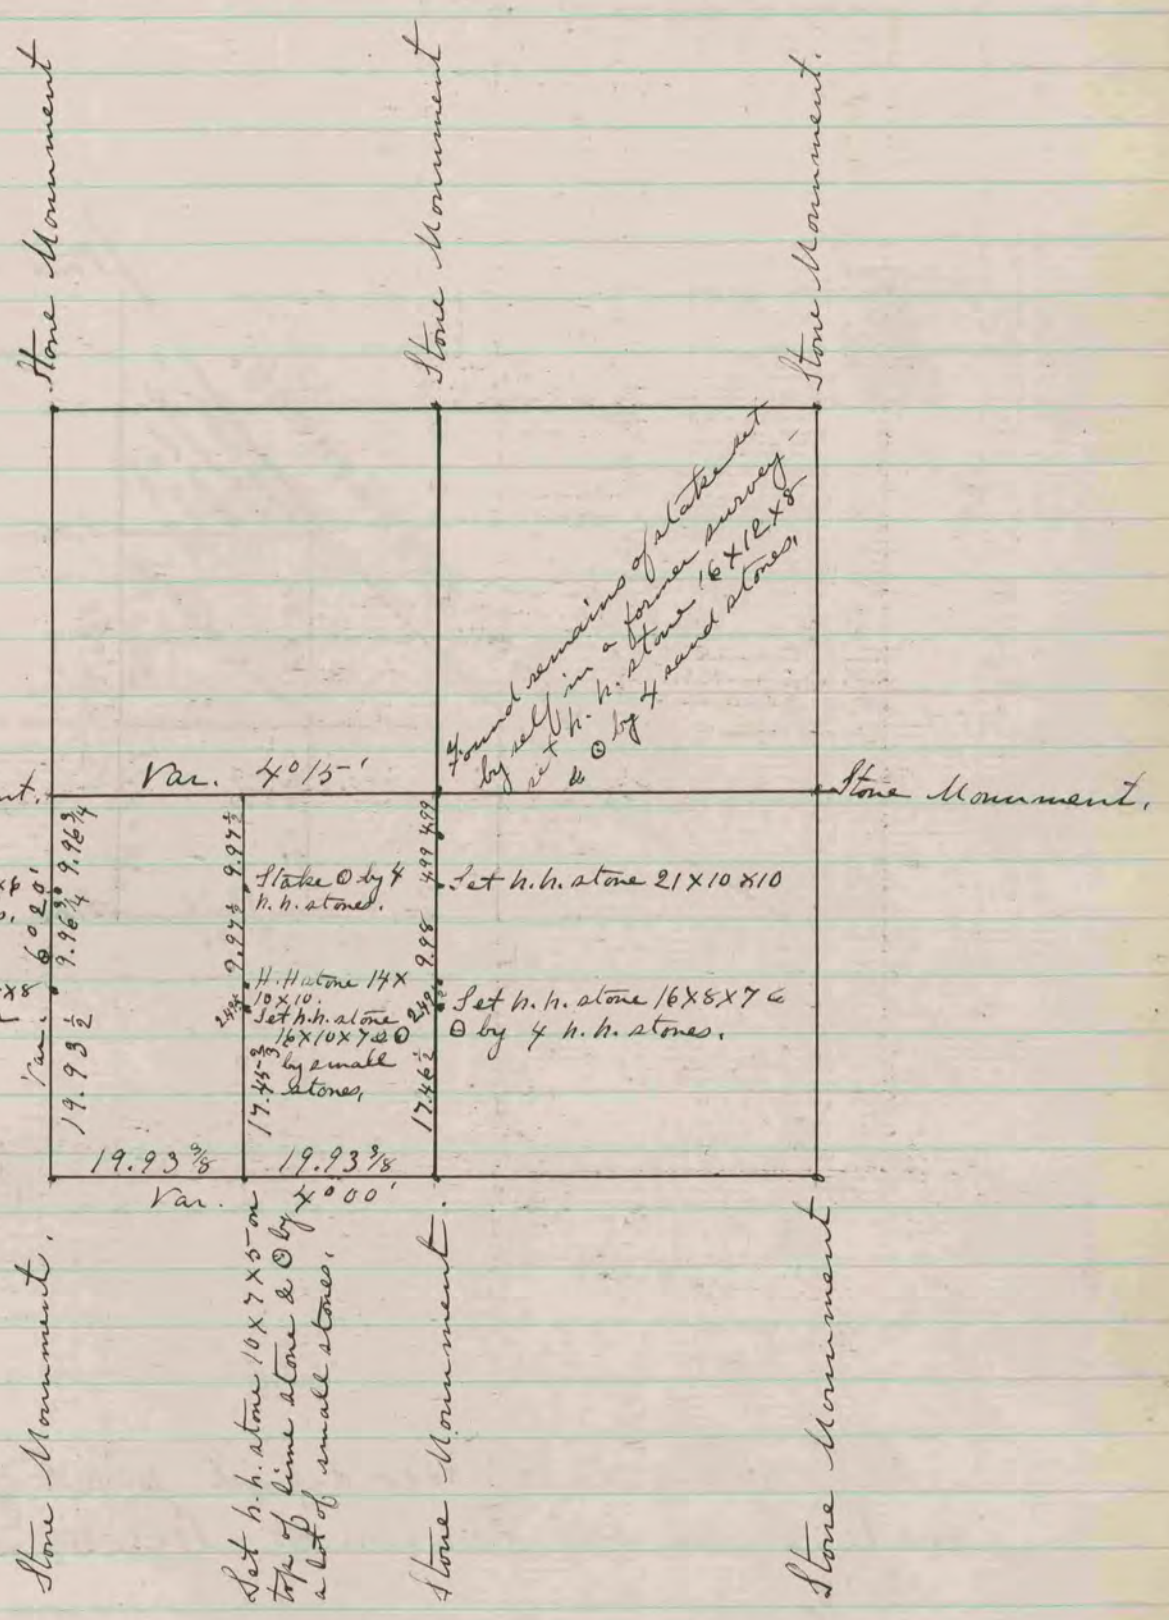

The above is a record and plat of a survey made by me on sec. 13 Harmony May 4. 1878

Edward Ruger
County Surveyor.

COUNTY SURVEYOR
RECORD 1859-1906