COUNTY SURVEYOR
RECORD 1 1851-1869

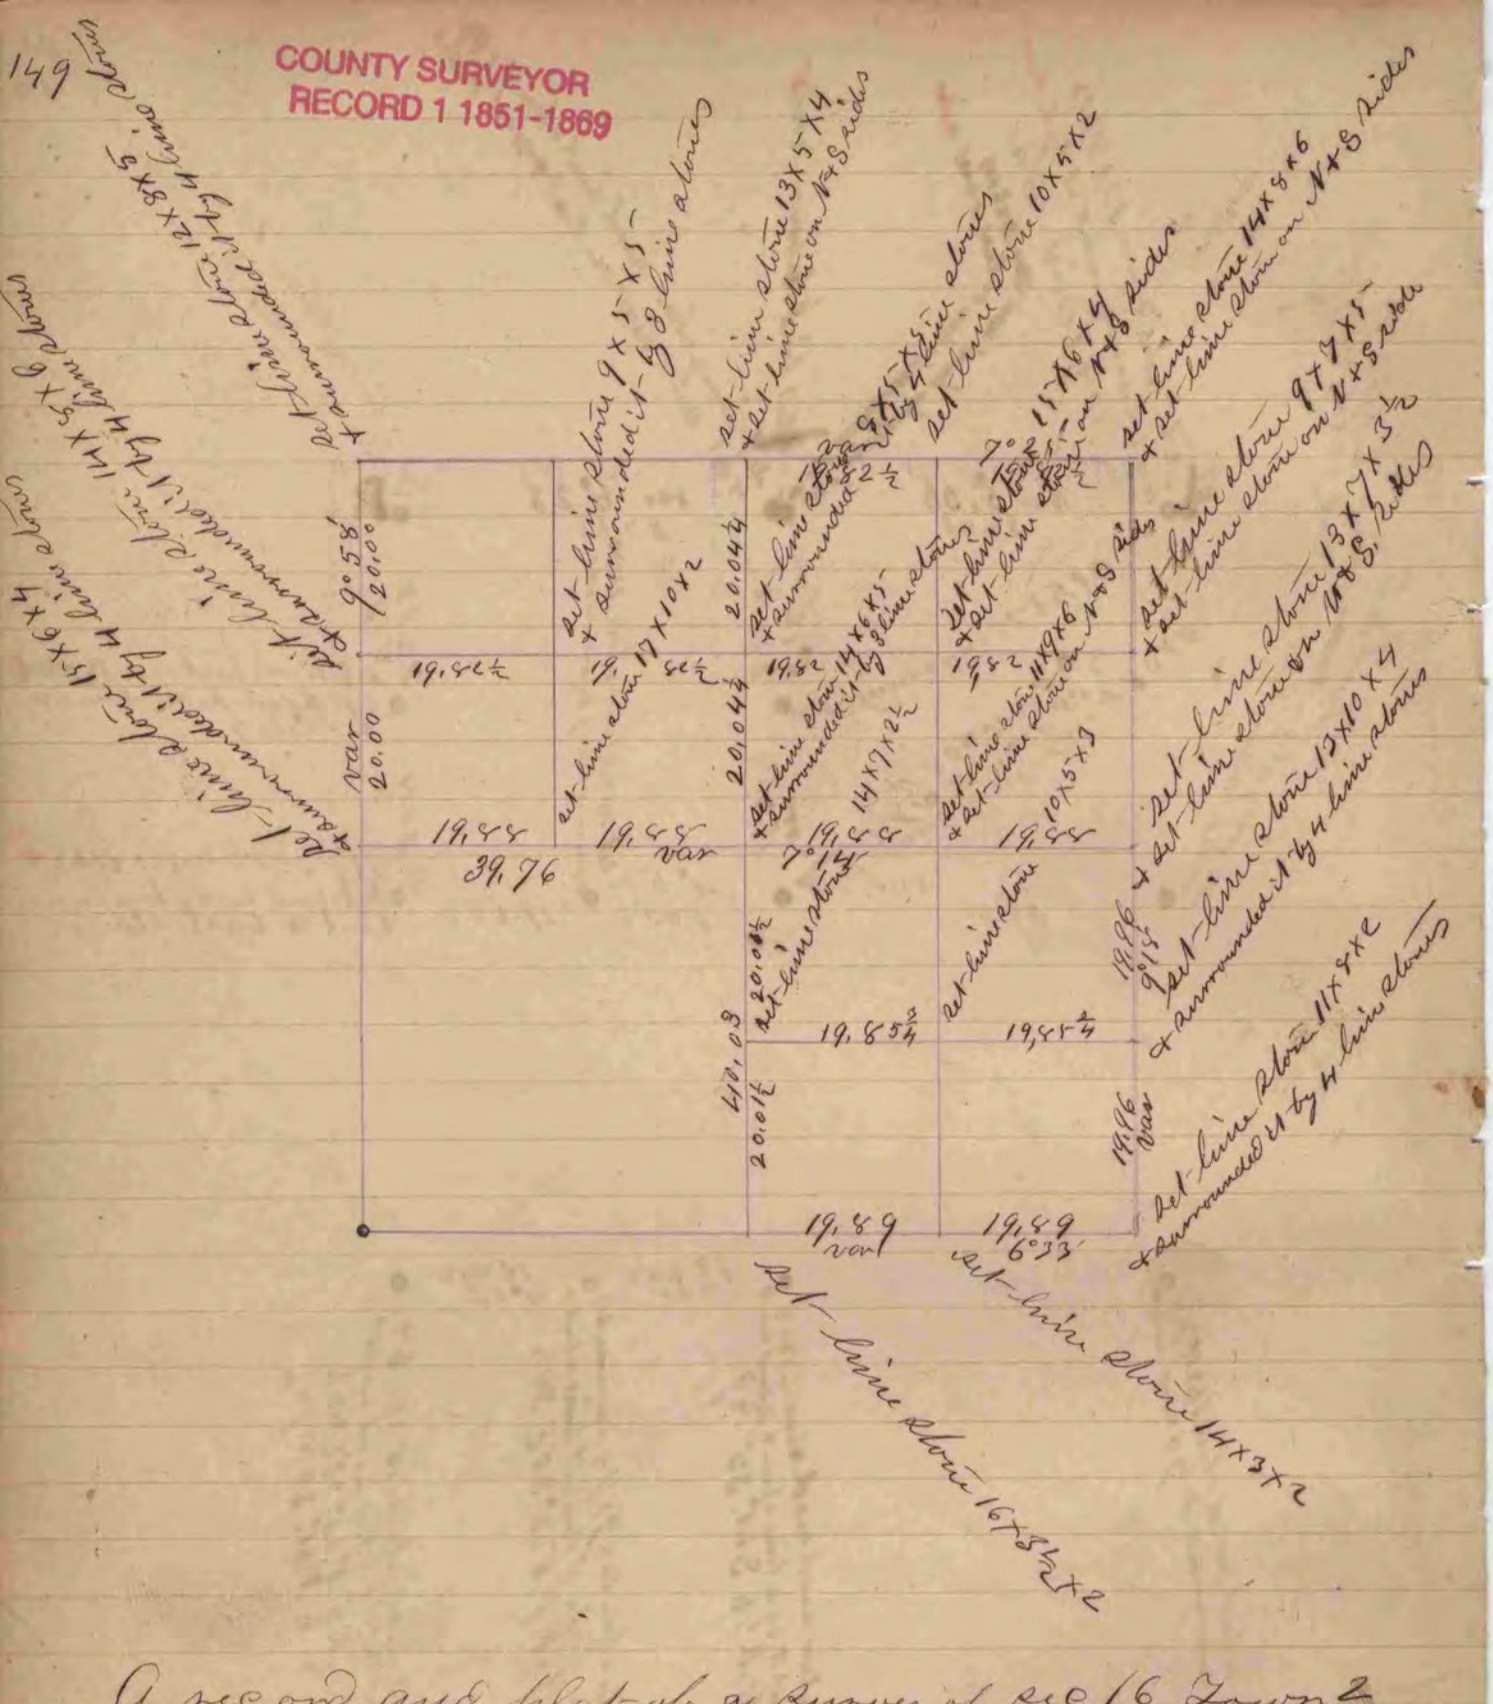

A record and plat of a Survey of Sec 16 Town 2 Range 13 made October 4th & 5th 1860 by Edward Ruger
La Prairie
