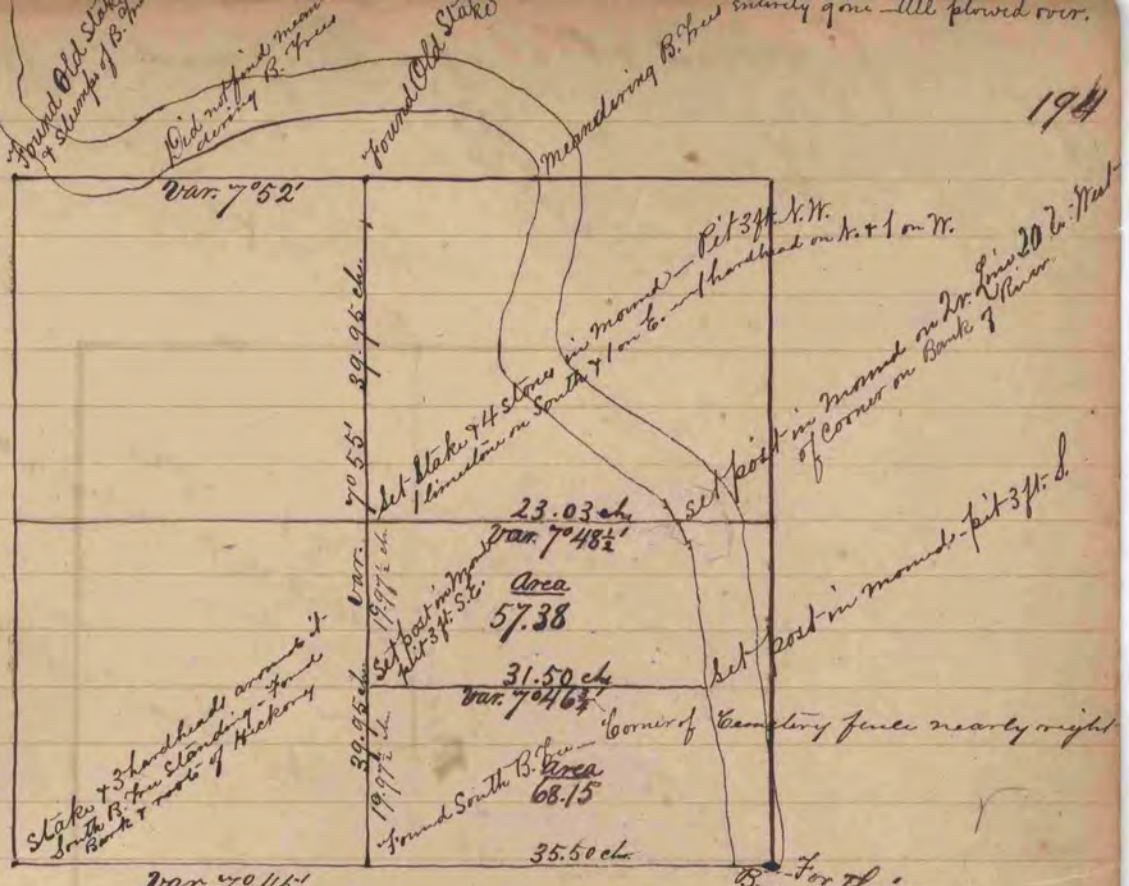

A Record & Plat of a Survey made on Sec. 23, T. 3 N. R. 12 E. Aug. 14 & 18, 1863 by S. D. Locke County Surveyor in Janesville and for Rock County, Wis.—

Meander-Line of River of River Commences on South Line of Section at Br. or Bl. O. 17 inches on Corner on River, running Thence North 19½ West, 3 chs.; Thence N. 17½ W., 5 chs.; Thence N. 13½ W., 7 chs.; Thence N. 15½ W., 2 chs.; Thence N. 20½ W., 2 chs.; Thence N. 60¾ W., 1.74½ chs.; Thence N. 13 E., 2 chs.; Thence N. 12 W., 1 ch.; Thence N. 28¾ W., 4 chs.; Thence N. 32 W., 2.75 chs.; Thence N. 31 W., 3.27 chs.; Thence N. 39¼ W., 4 chs.; Thence N. 45 W., 2 chs.; Thence N. 42 W., 3.65 chs., to the Quarter Line, 20 links East of Post in Mound — Bearings given according to Magnetic Meridian, as indicated by needle.

COUNTY SURVEYOR
RECORD 1 1851-1869