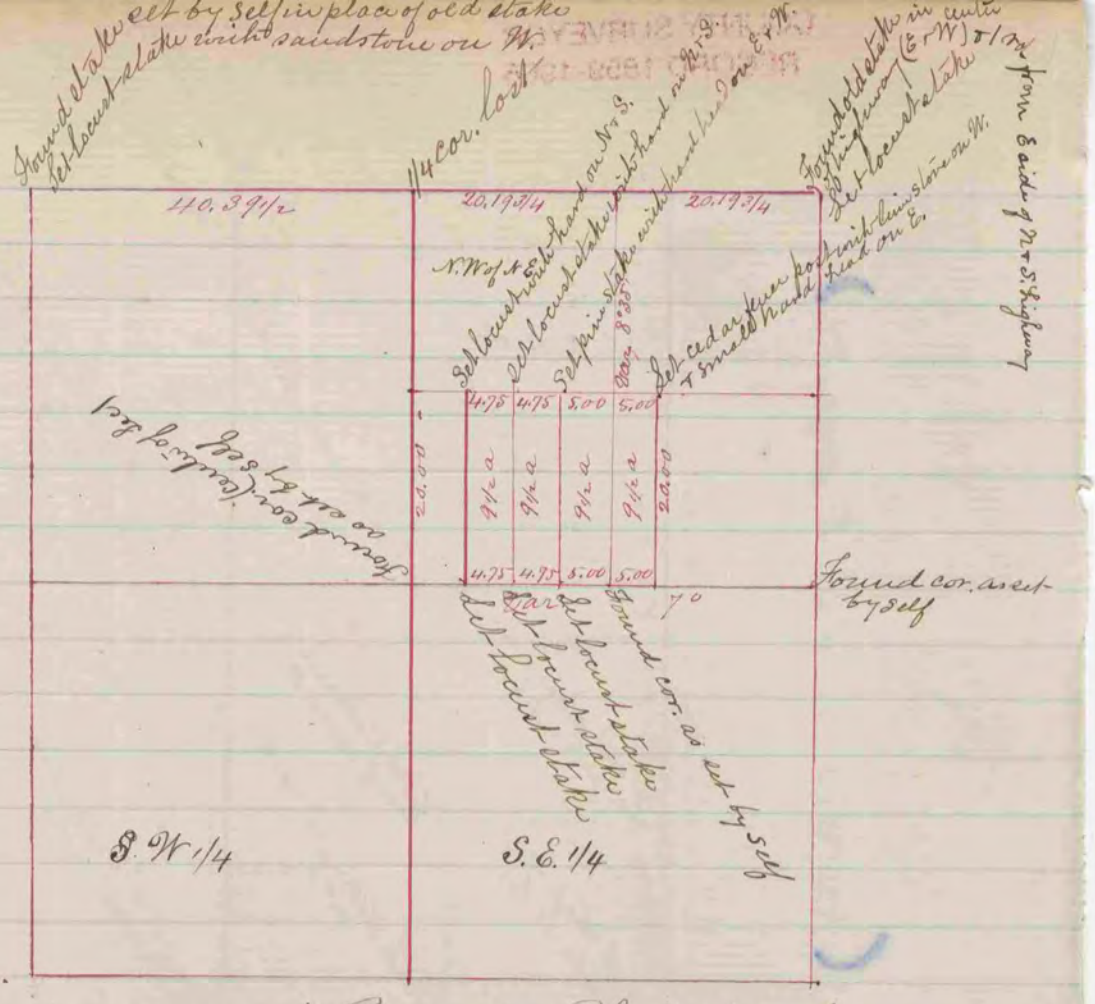

The above is a correct Record & Plat of a Survey made by me Apr. 20 1868 on Sec. 34 Jonesville

S. D. Locke Co. Surveyor

(Recorded in Vol I page 319)

COUNTY SURVEYOR
RECORD 1859-1906