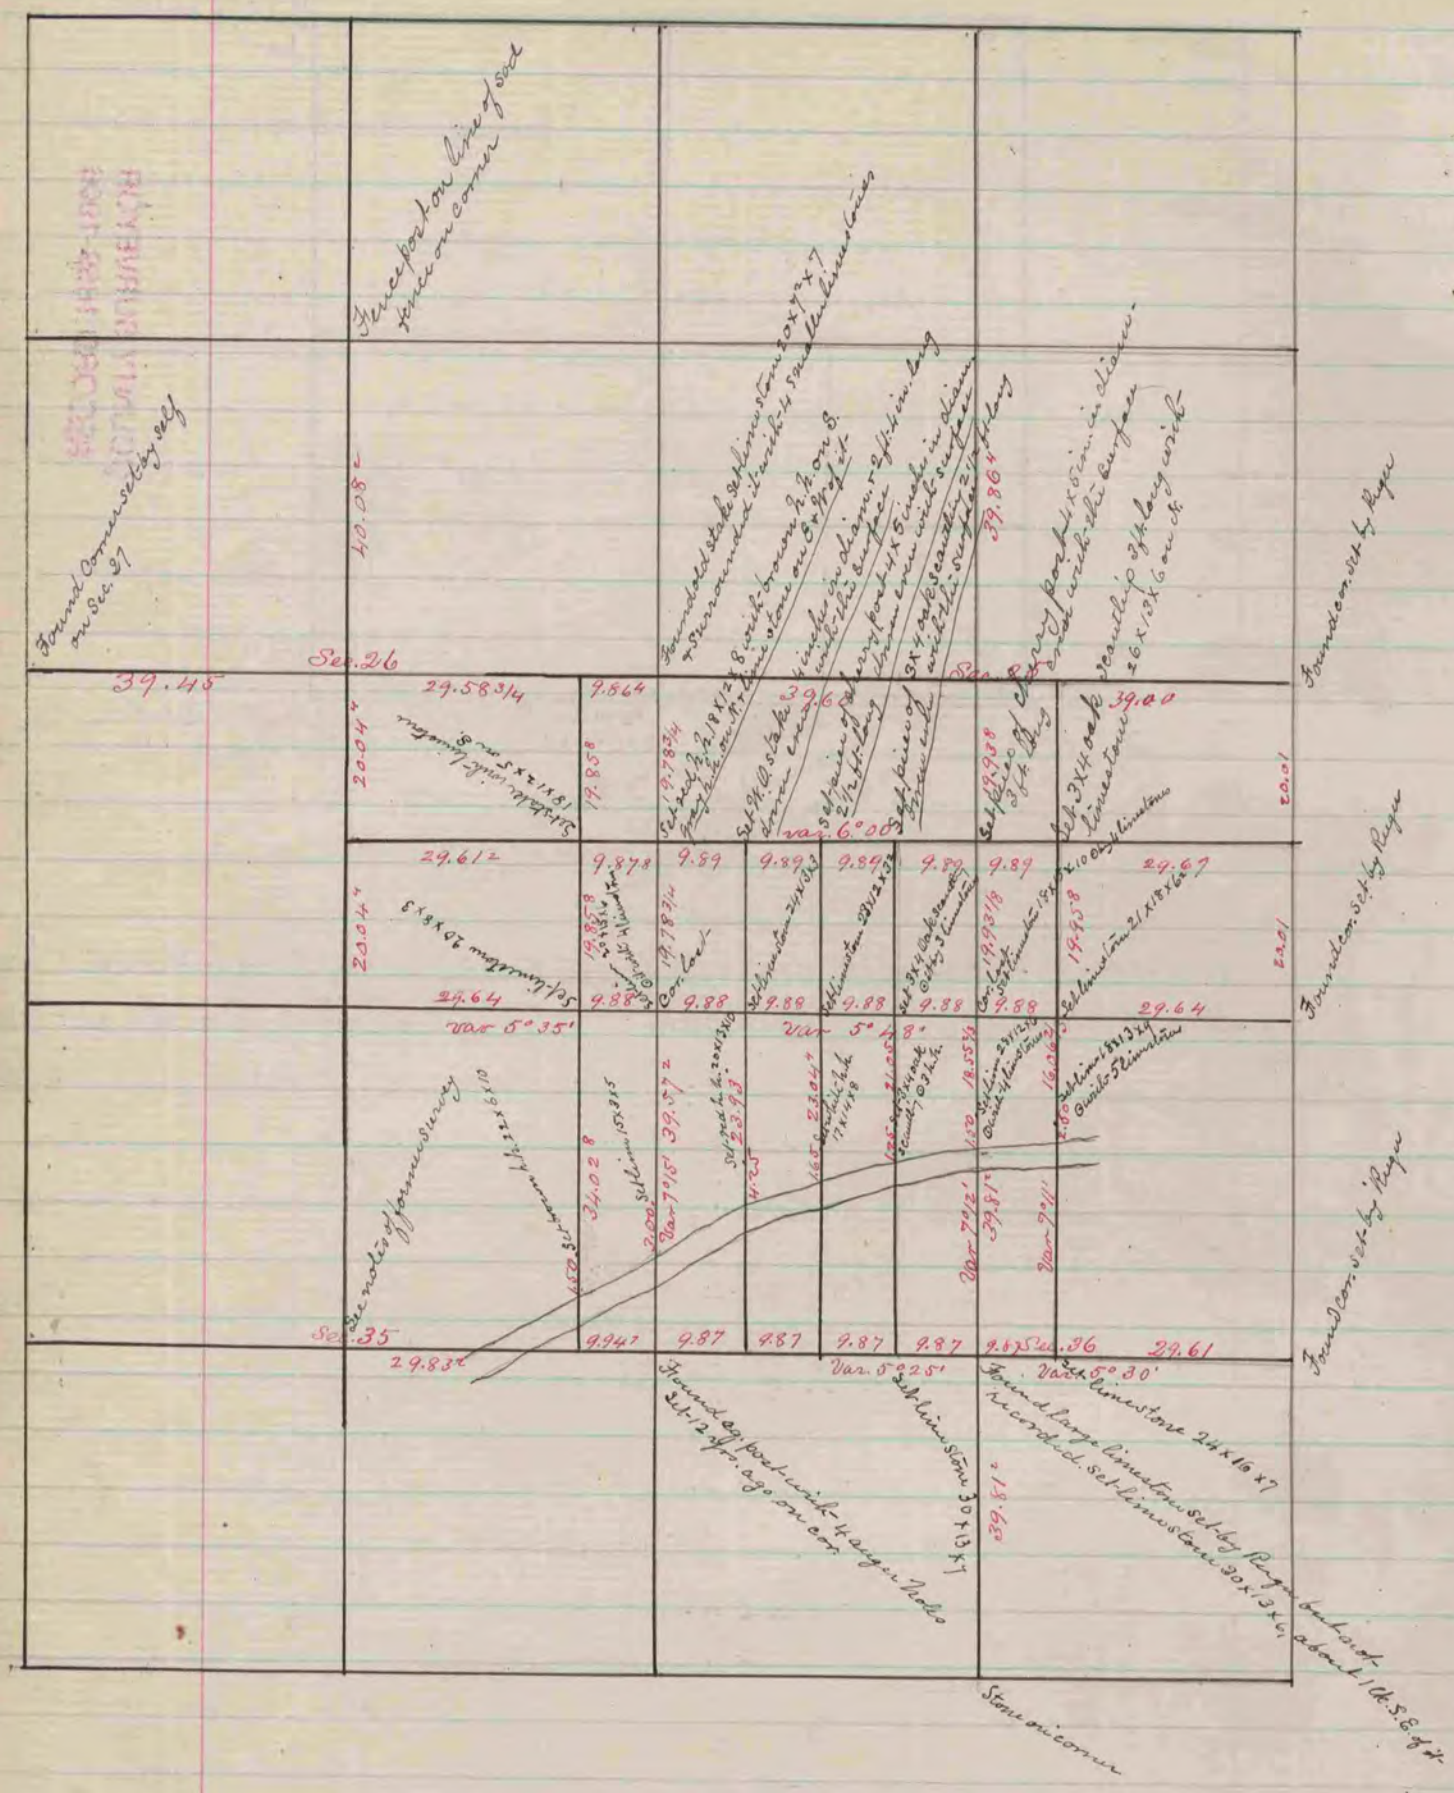

A Record of a Plat & Survey made by me June 12, 13, 15 & 16 1865 on Secs. 25, 26, 35 & 36, Town of La Prairie – S. D. Locke Co. Sur

COUNTY SURVEYOR
RECORD 1859-1906