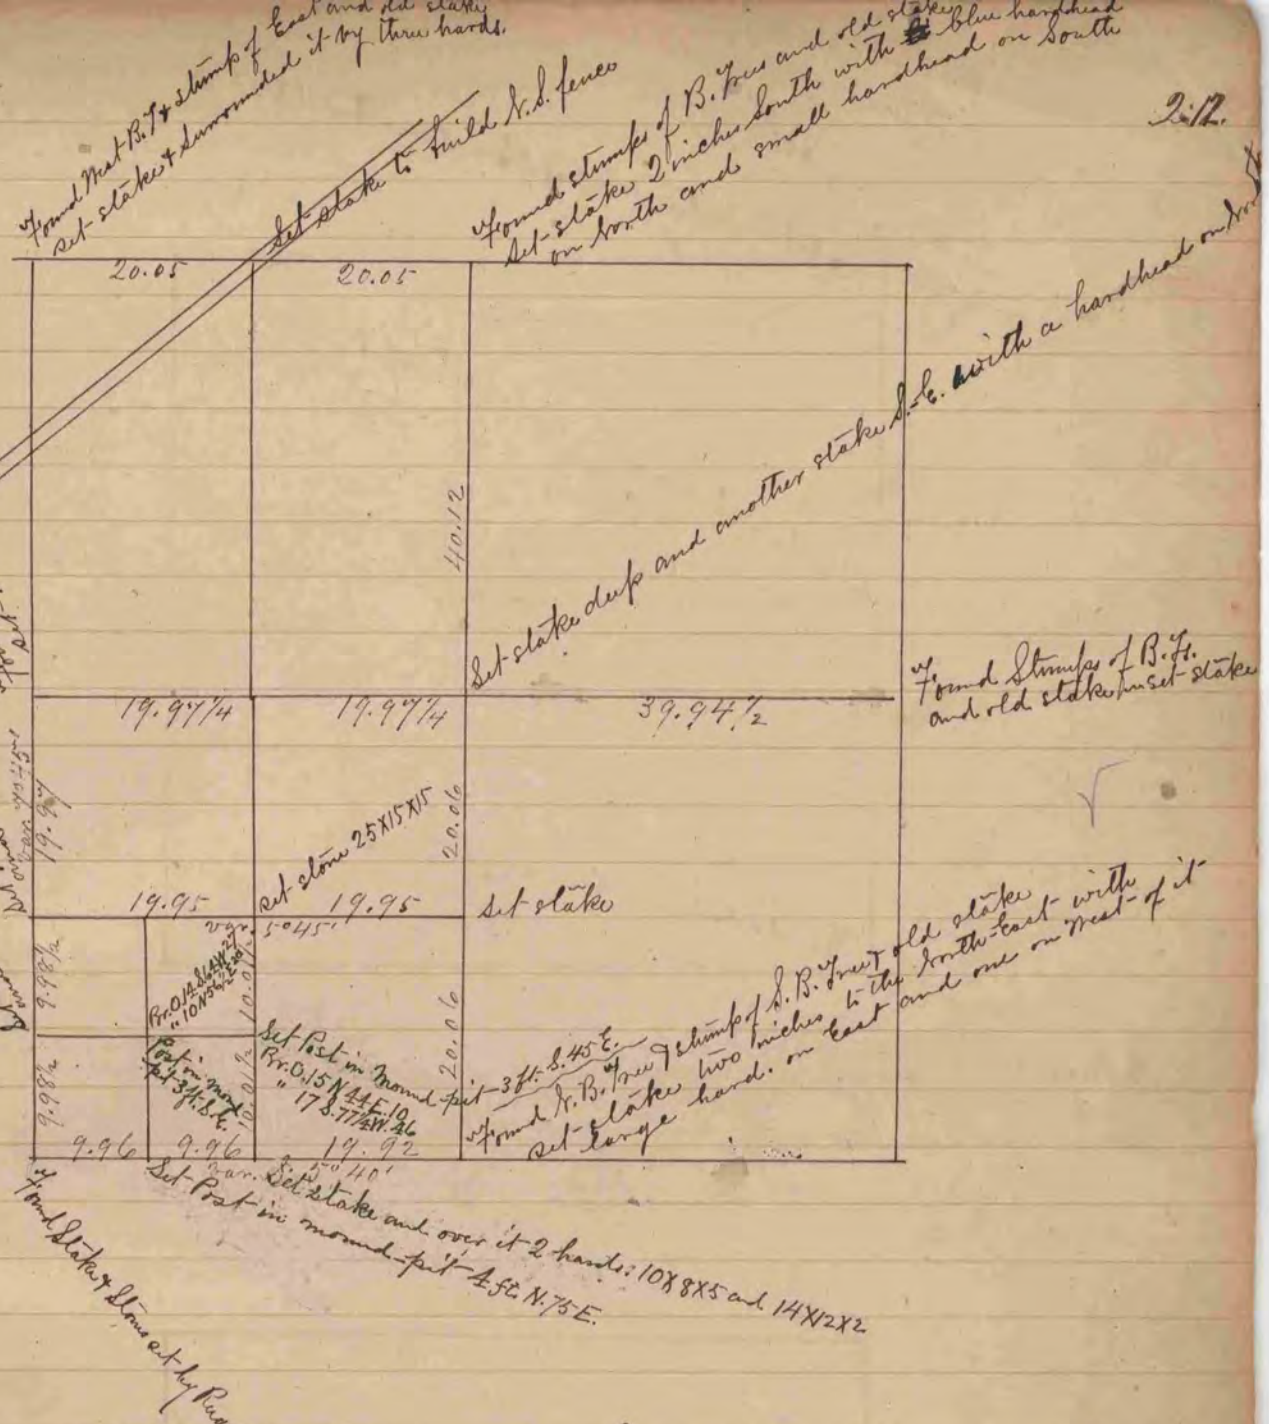

A Record Plat of a Survey made on Sec. 9 T. 3 R. 18 (Harmony) Nov. 29, 30 1864 by S.D. Locke Co. Surveyor in and for Rock Co. Wis.

Harmony

(Make note on page 187 new record)

COUNTY SURVEYOR
RECORD 1 1851-1869