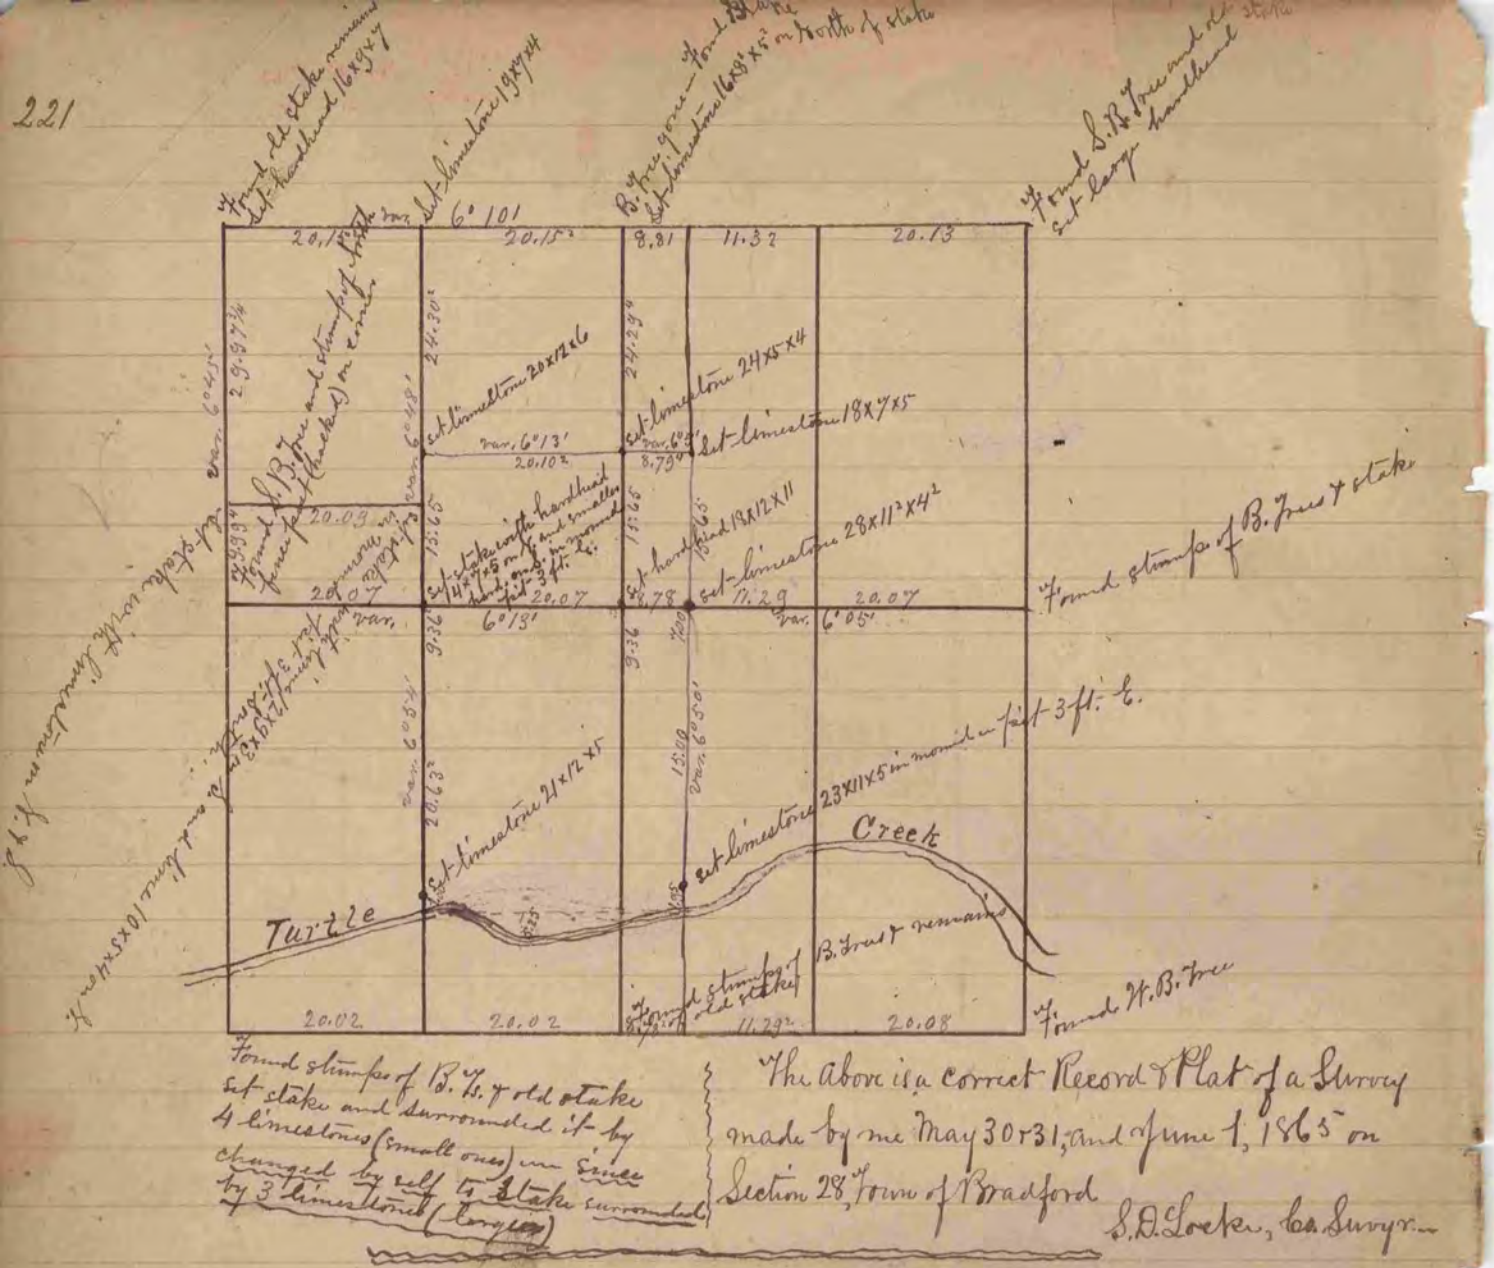

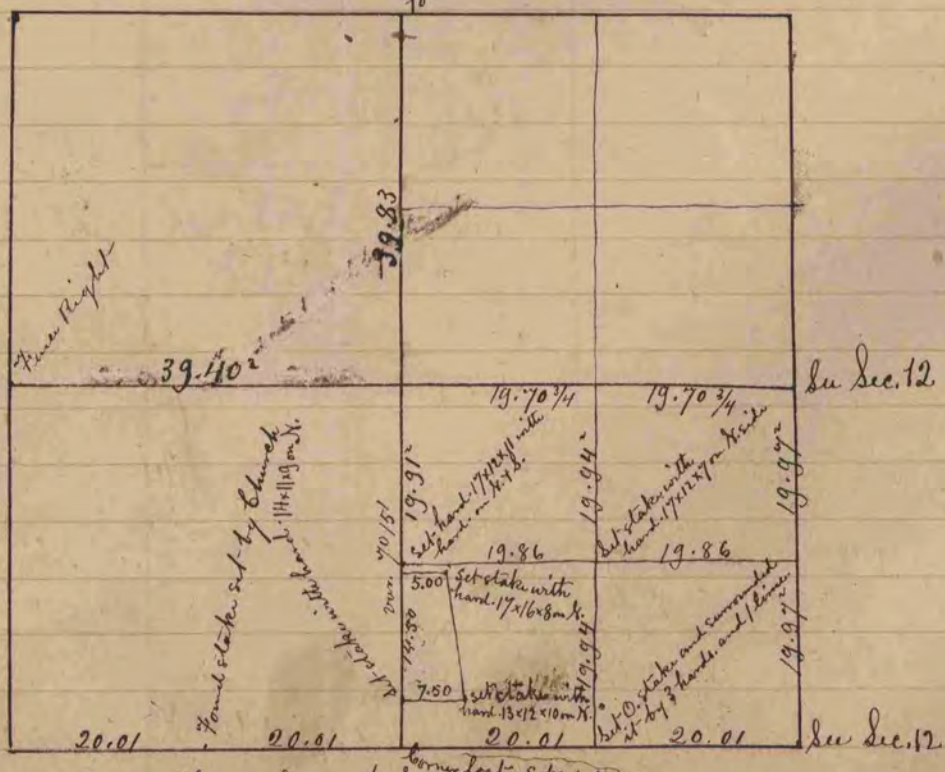

"The above is a correct Record & Plat of a Survey made by me July 6 & 7, 1865, in Sec. 11, Town of Plymouth
S.D. Locke County Surveyor

COUNTY SURVEYOR
RECORD 1 1851-1869