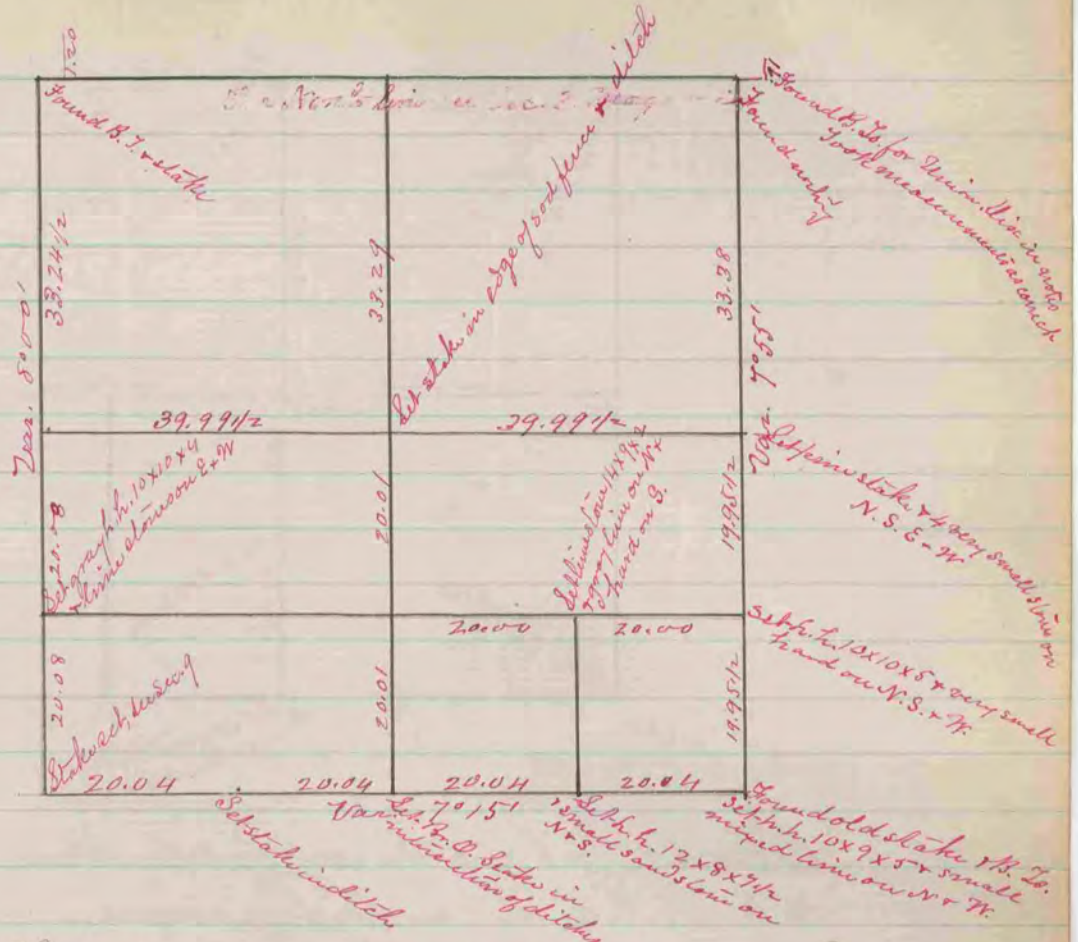

Record of Plat of a survey made Dec. 9 1863 on Sec. 3 T3 N R 10 E. by S.D. Locke Co. Surveyor. Magnolia

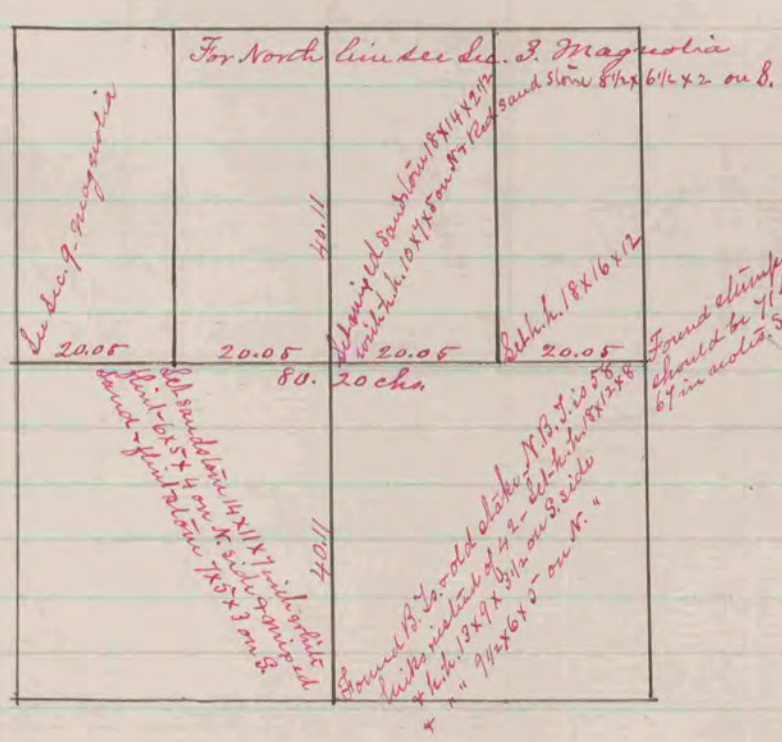

Record of Plat of a survey made Dec. 10 1863, on Sec 10 T3 R10E by S.D. Locke Co. Surveyor Magnolia

COUNTY SURVEYOR
RECORD 1859-1906