COUNTY SURVEYOR
RECORD 1 1851-1869

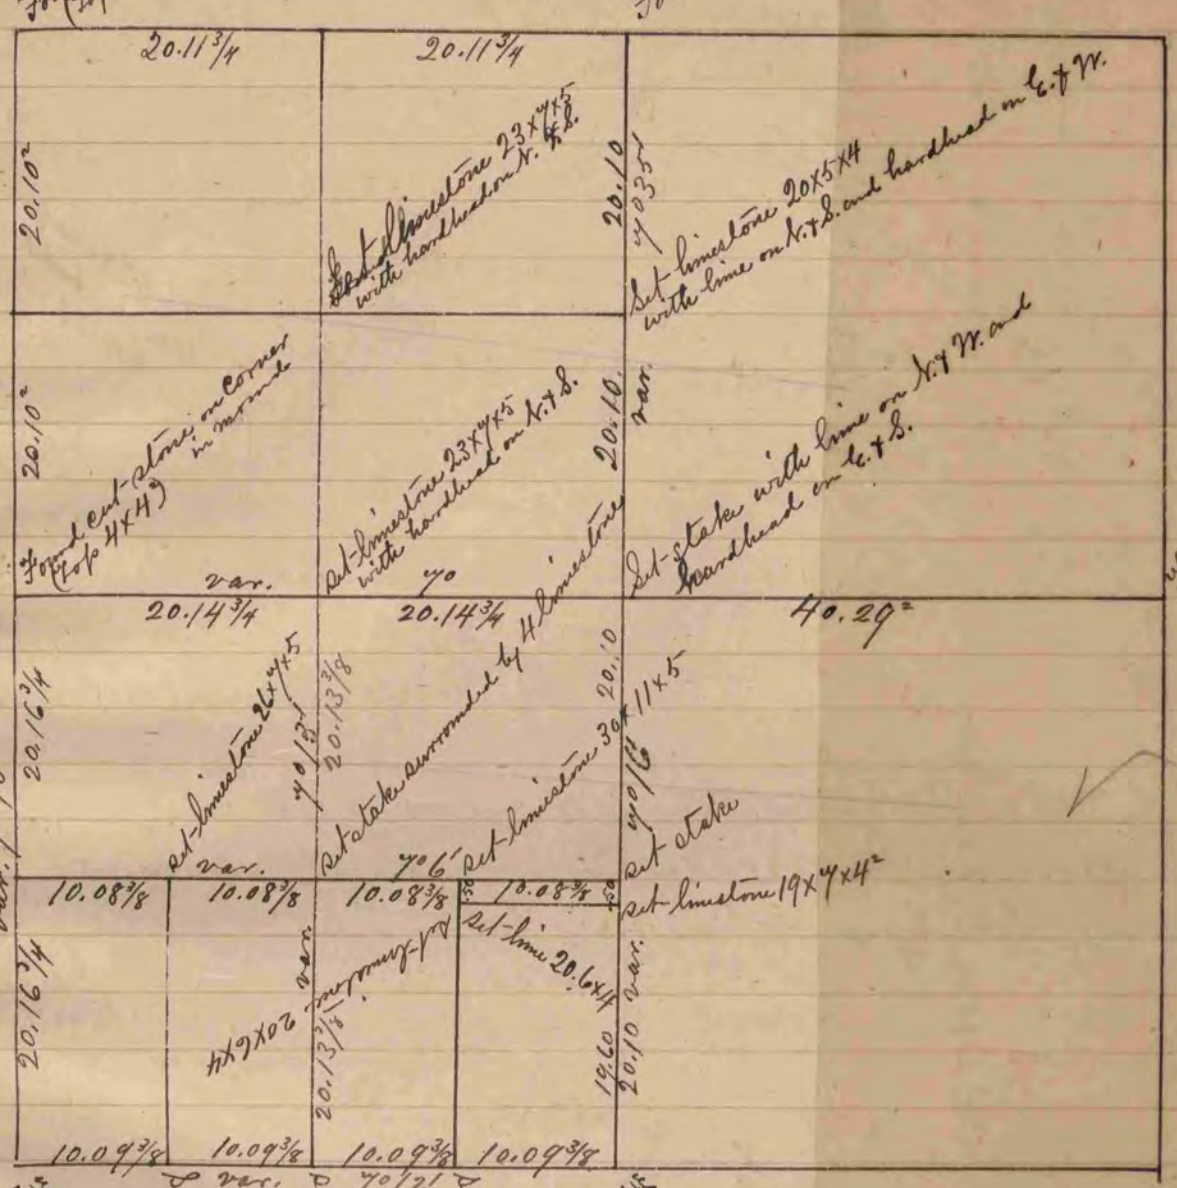

"The above is a Correct Record & Plat of a Survey made by me on Sec. 24, Center, May 29, 1866.

S. D. Locke
County Surveyor in & for
Rock Co. Wis.