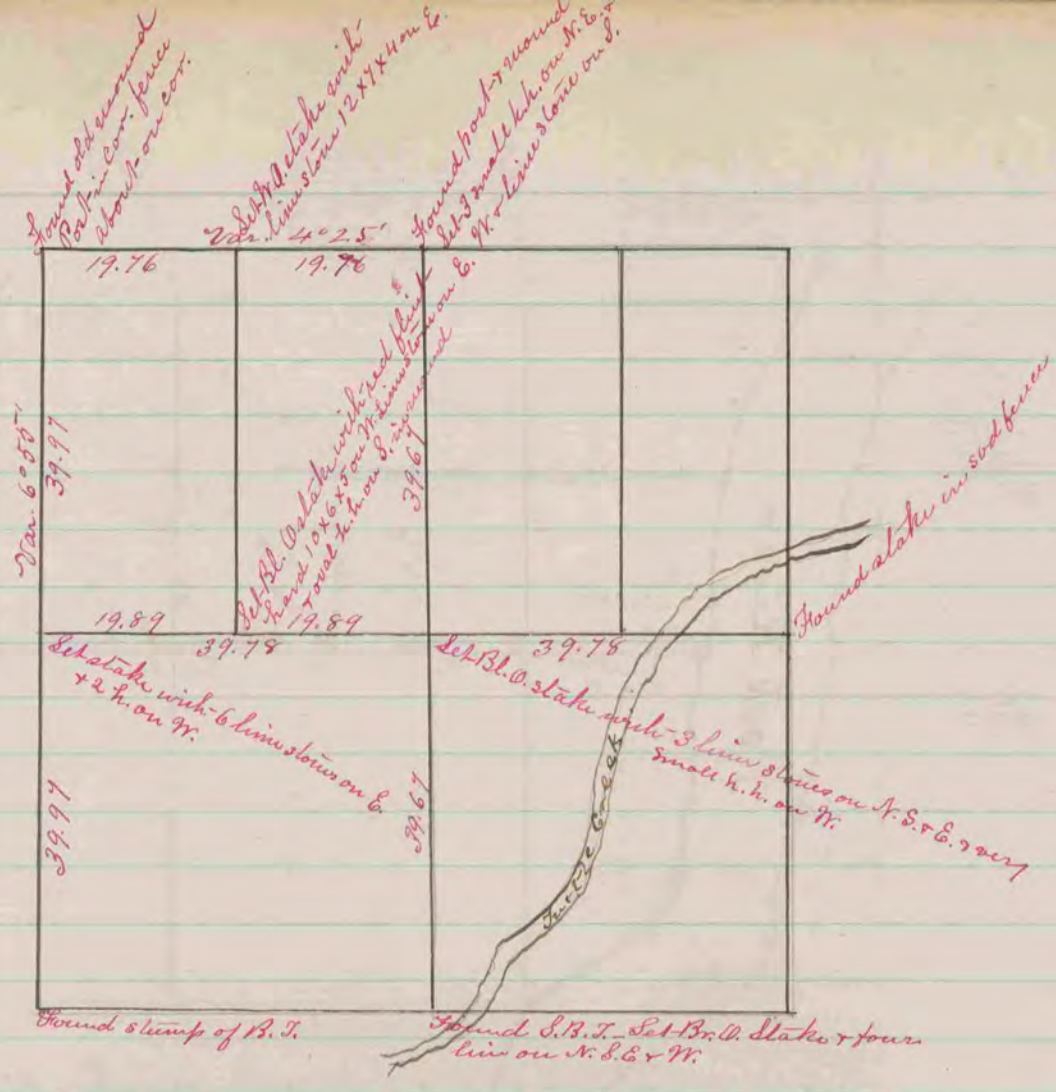

Record + Plat of a survey made on Sec. 35 T. 2 R 13 E.
May 19 1864 by S. D. Locke Co. Surveyor La Prairie

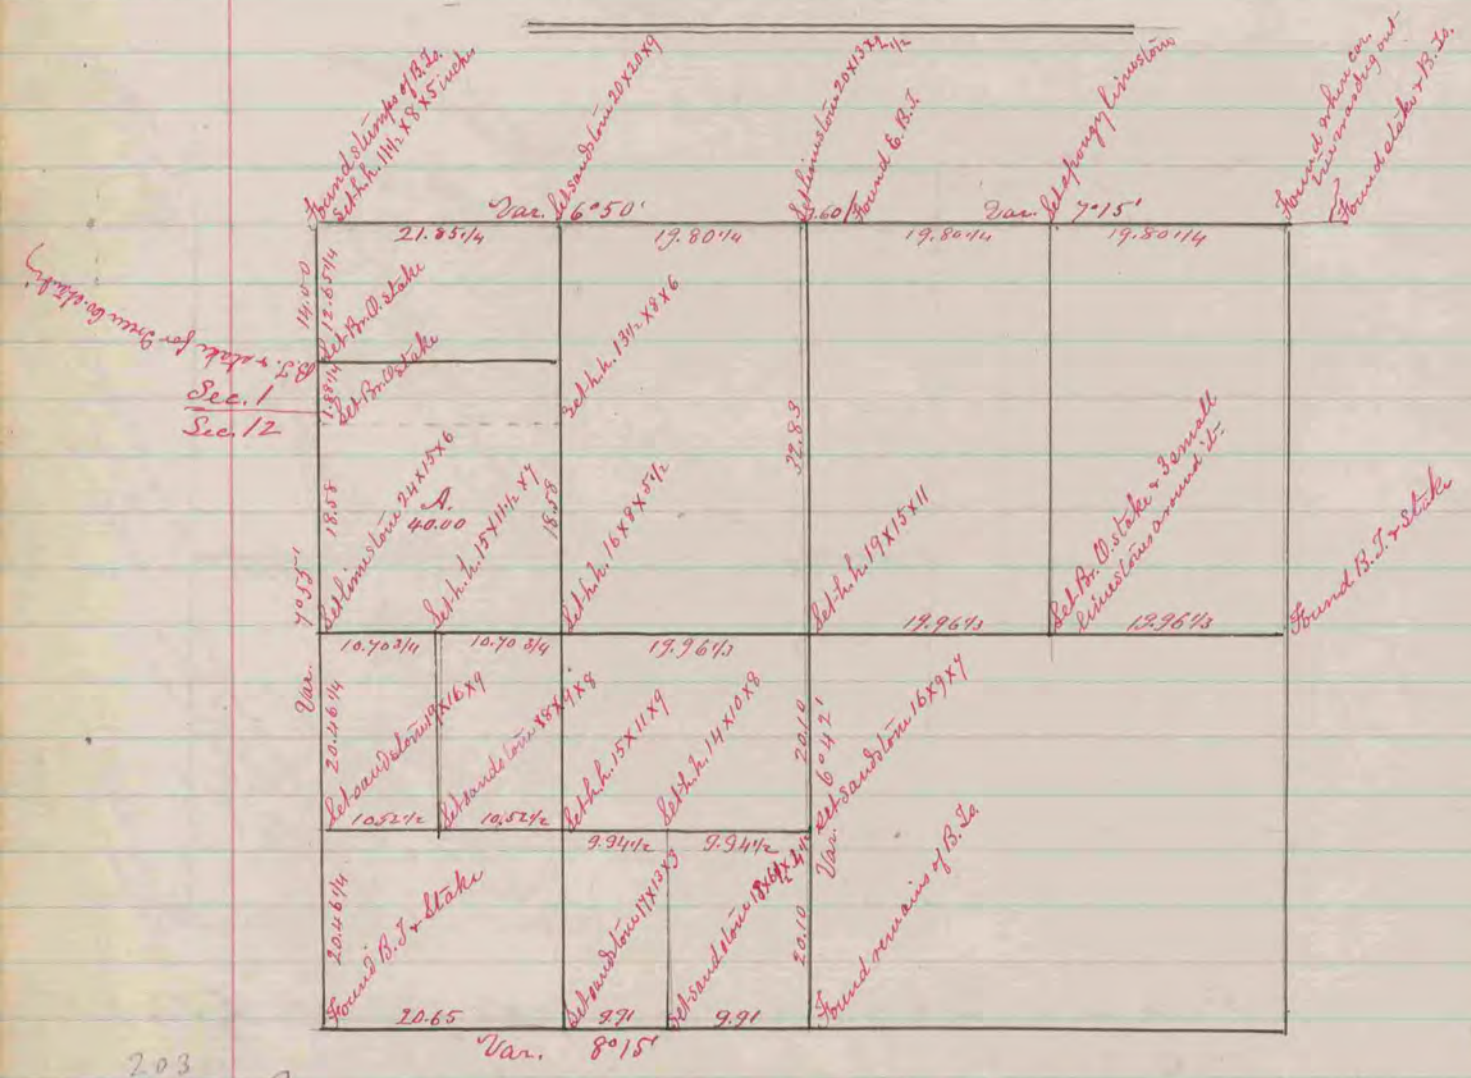

203

Record + Plat of a Survey made on Sec 6. T. 3. N. R. 10 E.
April 21 + 22. 1864 by S. D. Locke C. Surveyor Magnetic

COUNTY SURVEYOR
RECORD 1859-1906