COUNTY SURVEYOR
RECORD 2 1869-1900

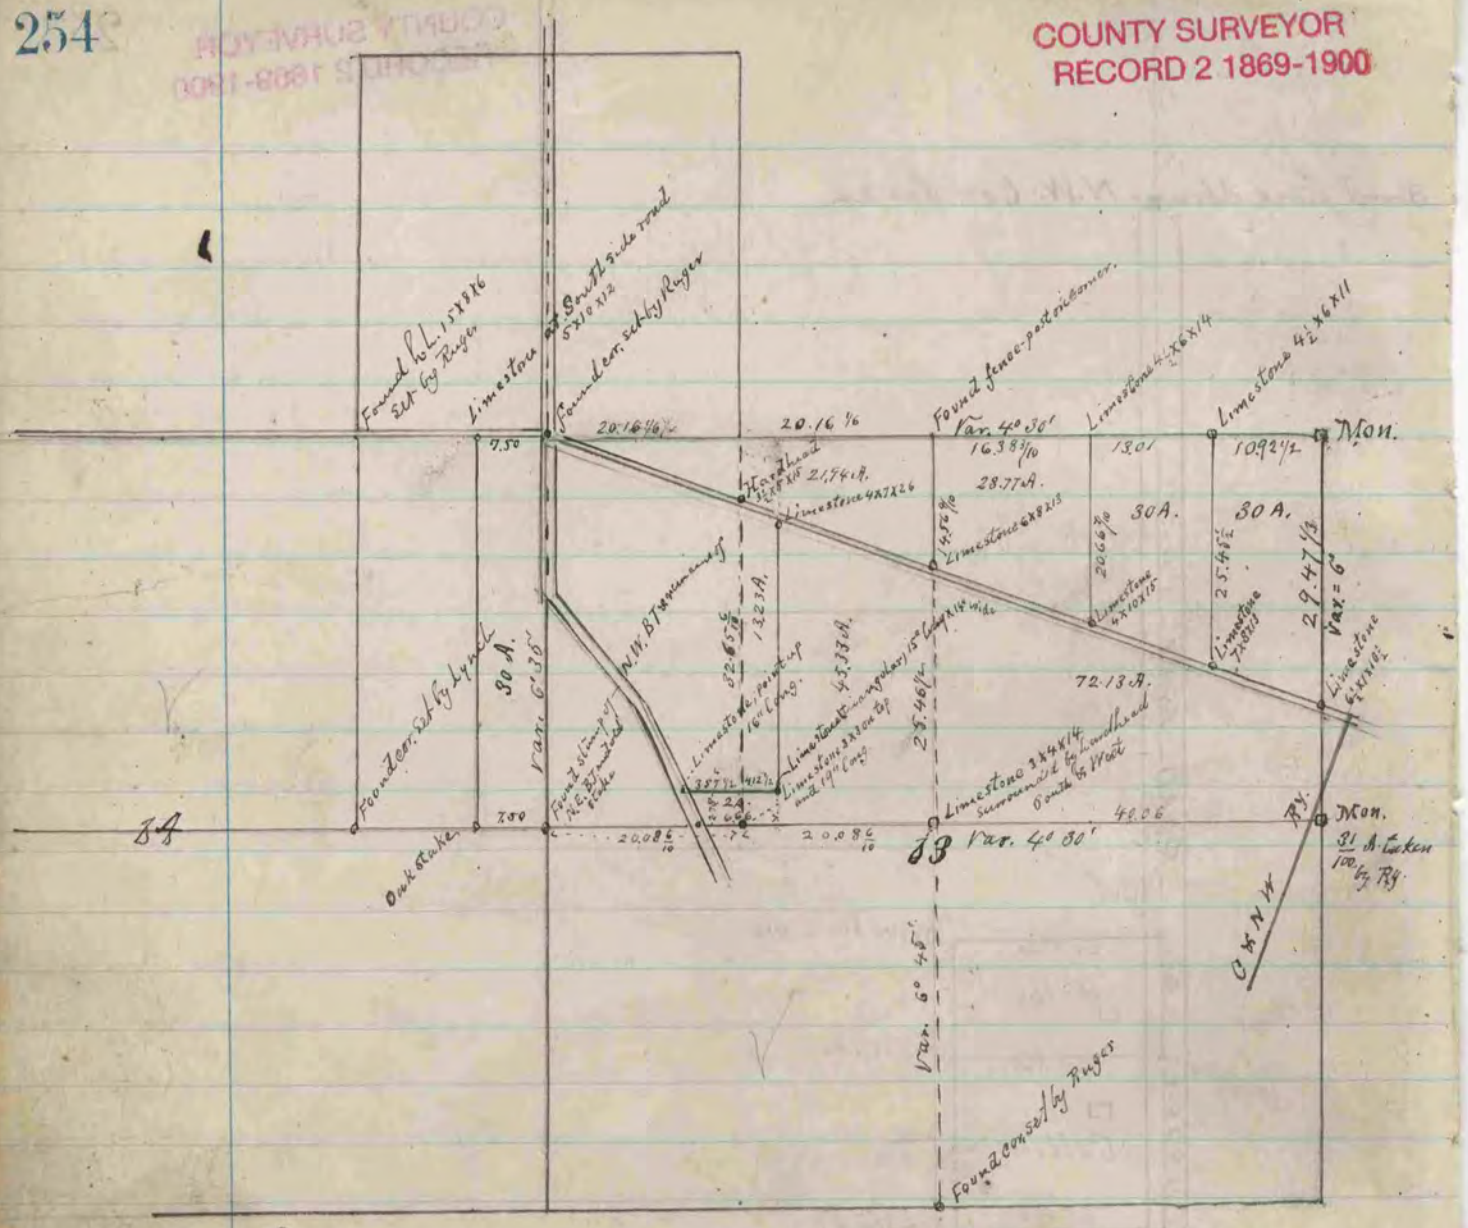

The above is a record and plat of a survey made by me June 3d 4th & 6th 1880 on Sections 13 and 14 Janesville

R. K. Lee Dep't C. Surveyor.

The above is a record and plat of a survey made by me June 7th 1880 on Section 15 Turtle.

R. K. Lee,

Dep't Co. Surveyor.