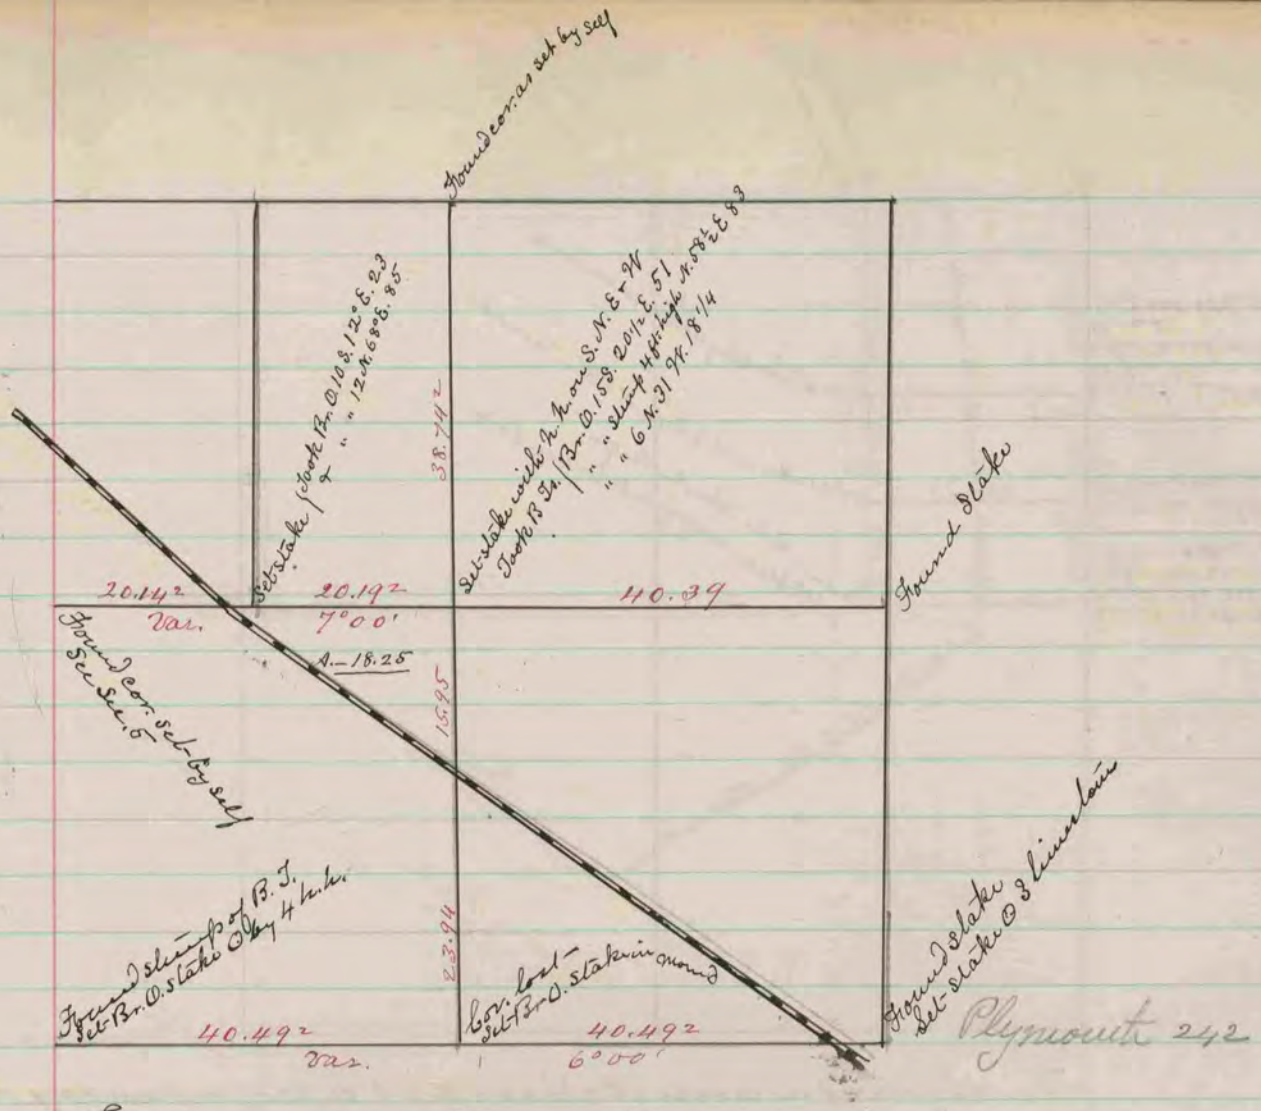

Plymouth 242

I hereby certify that the above is a correct Record & Plat of a survey made by me Dec. 27 - 1866. on Sec. 4 Plymouth - S. D. Locke Co. Surveyor Rock Co.

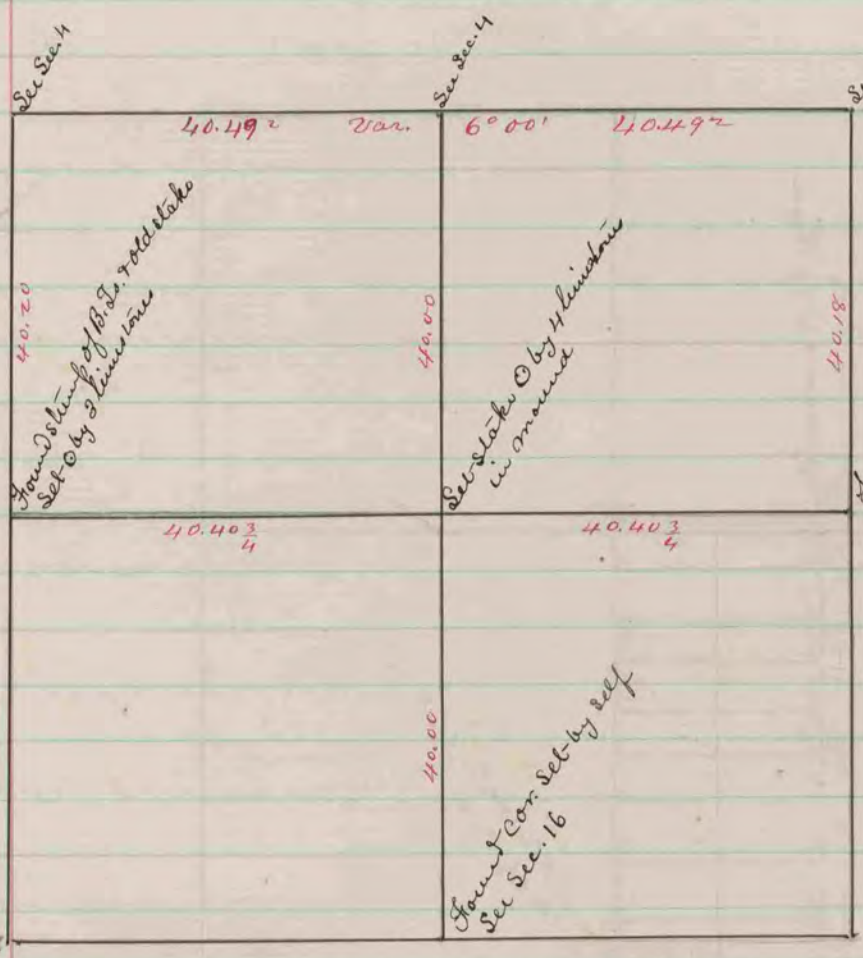

Plymouth 243

I hereby certify that the above is a correct Record & Plat of a survey made by me Dec. 28-1866, on Sec. 9 Plymouth -
S. D. Locke - Co. Surveyor Rock Co.

COUNTY SURVEYOR
RECORD 1859-1906