COUNTY SURVEYOR
RECORD 1859-1906

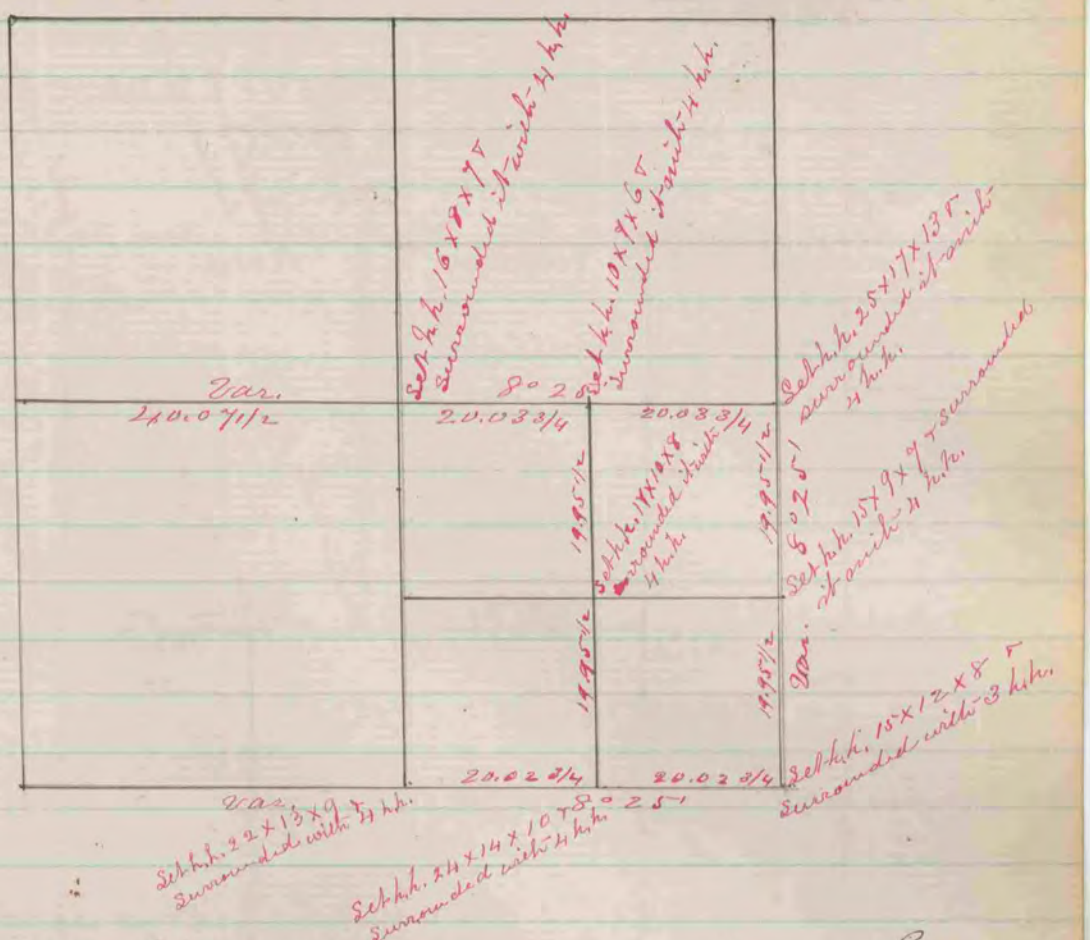

a Record & Plat of a survey made on Sec. 34 T. 4 R 11 March 30. 1861 by Edward Rogue Porter

Co. Surveyor