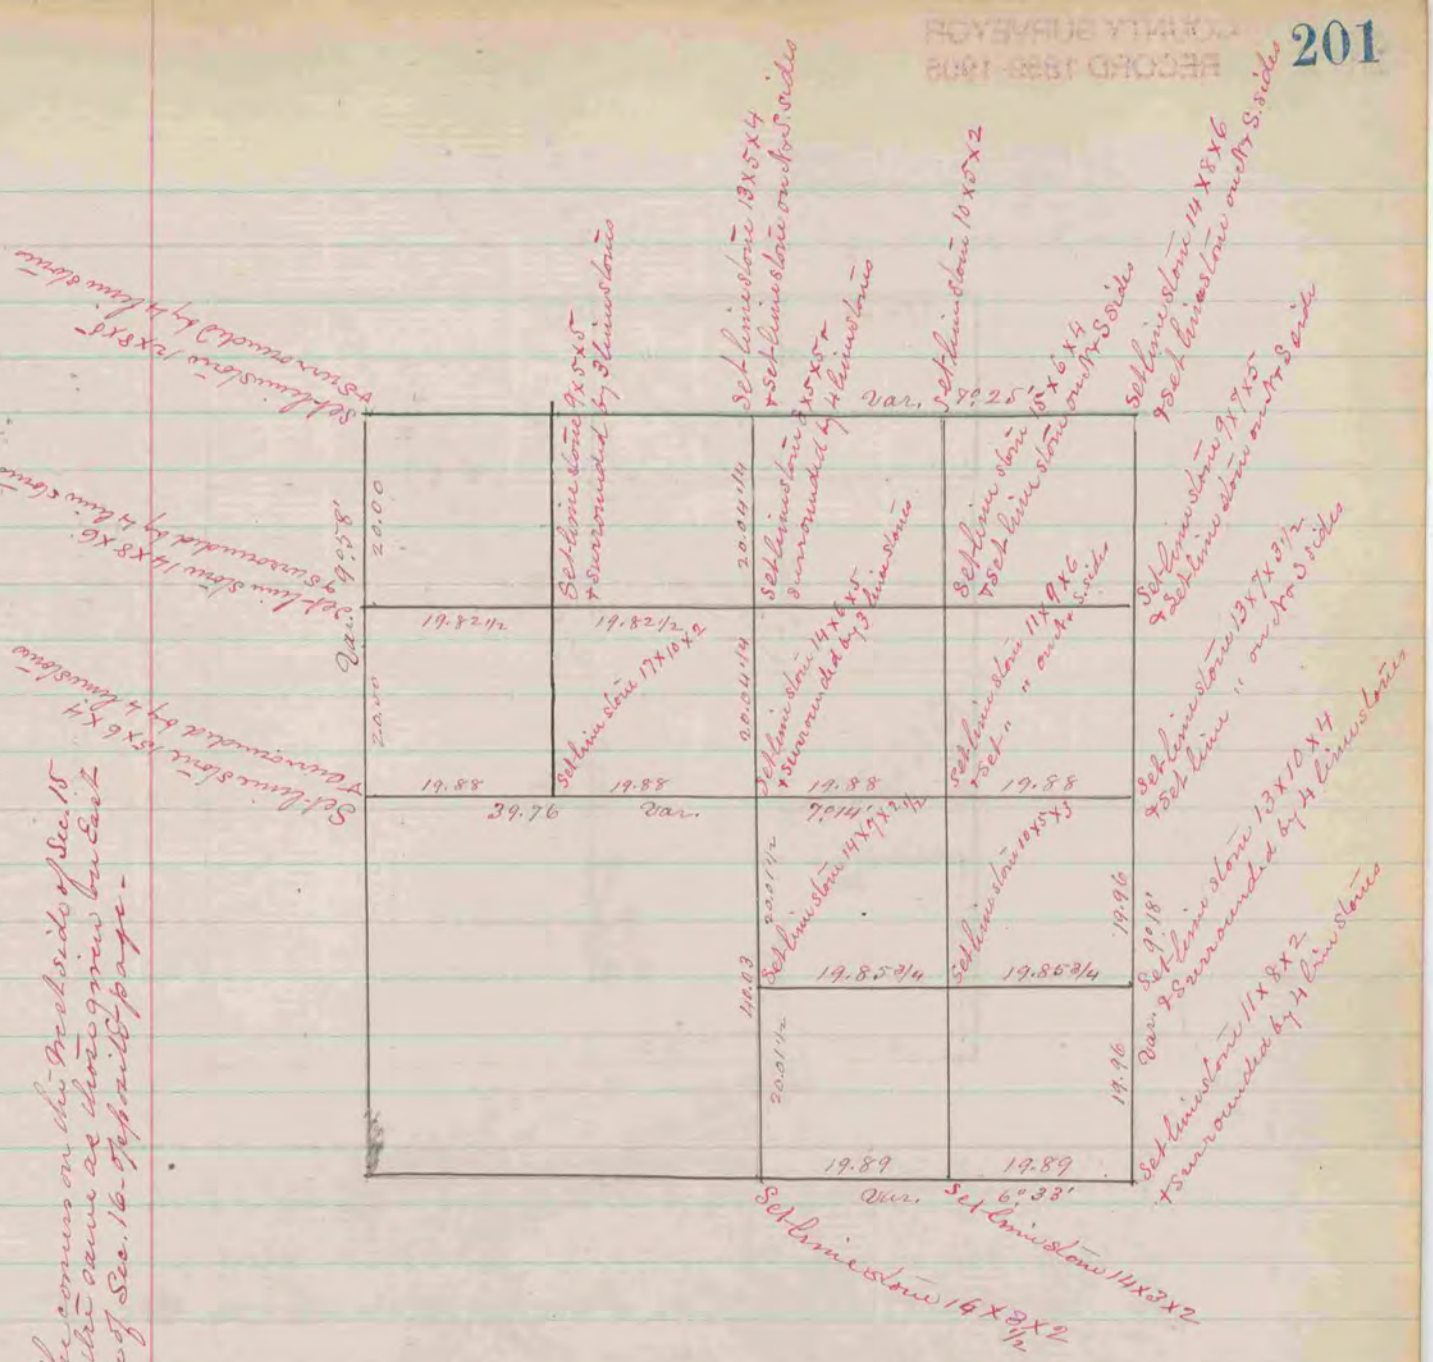

A Record & Plat of a survey of Sec. 16 T 2 R 13 made Oct. 4th & 5th 1860 by Edward Ruger Co. Surveyor La Prairie

COUNTY SURVEYOR
RECORD 1859-1906