(Recorded in Vol I page 289)

COUNTY SURVEYOR
RECORD 1859-1906

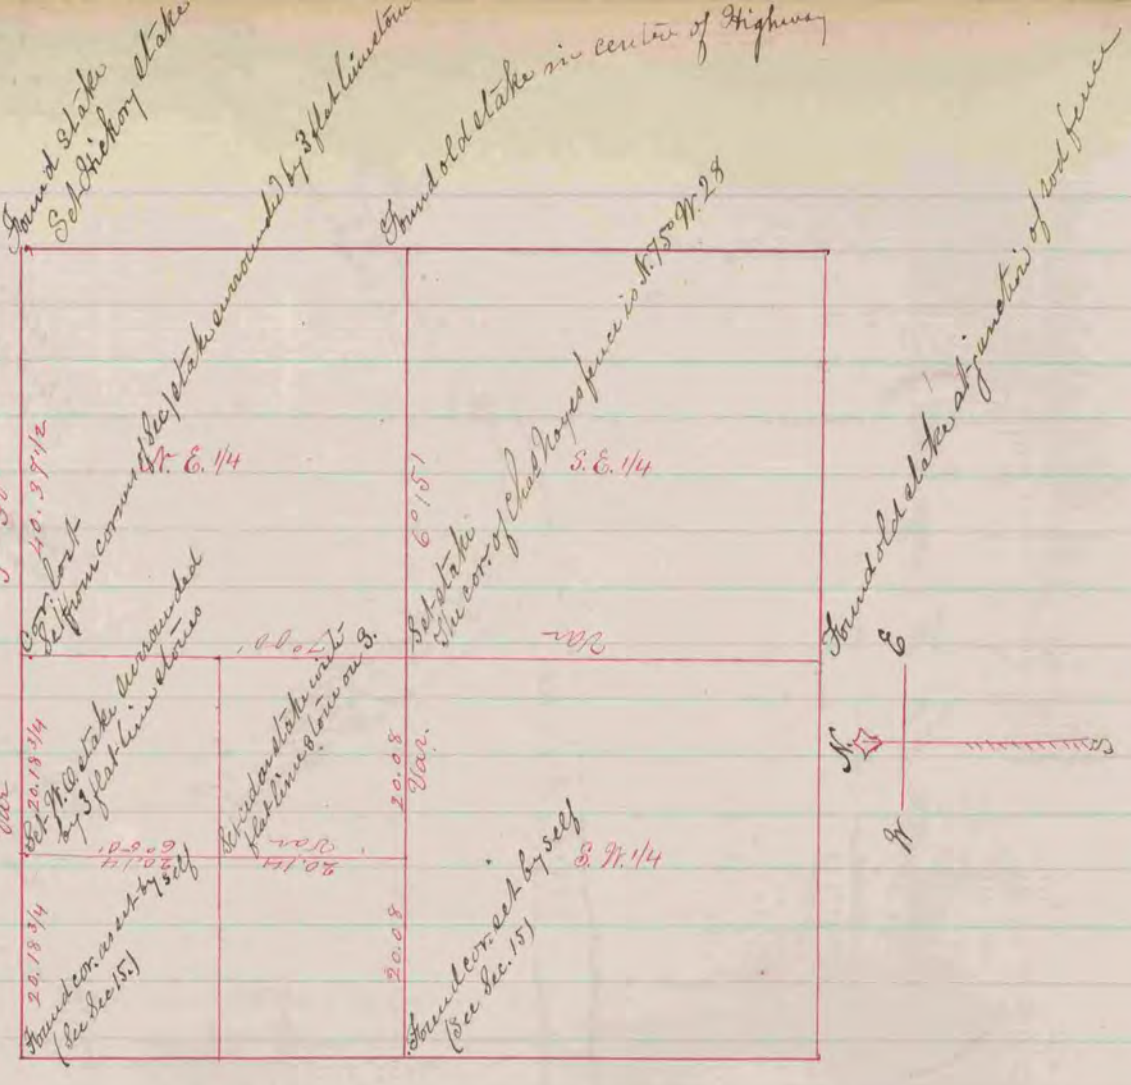

The above is a correct Record & Plat of a Survey made by me Sep. 9, 1867 on Sec. 14. Rock

S. D. Locke Co. Surveyor

(Recorded in Vol I page 321)

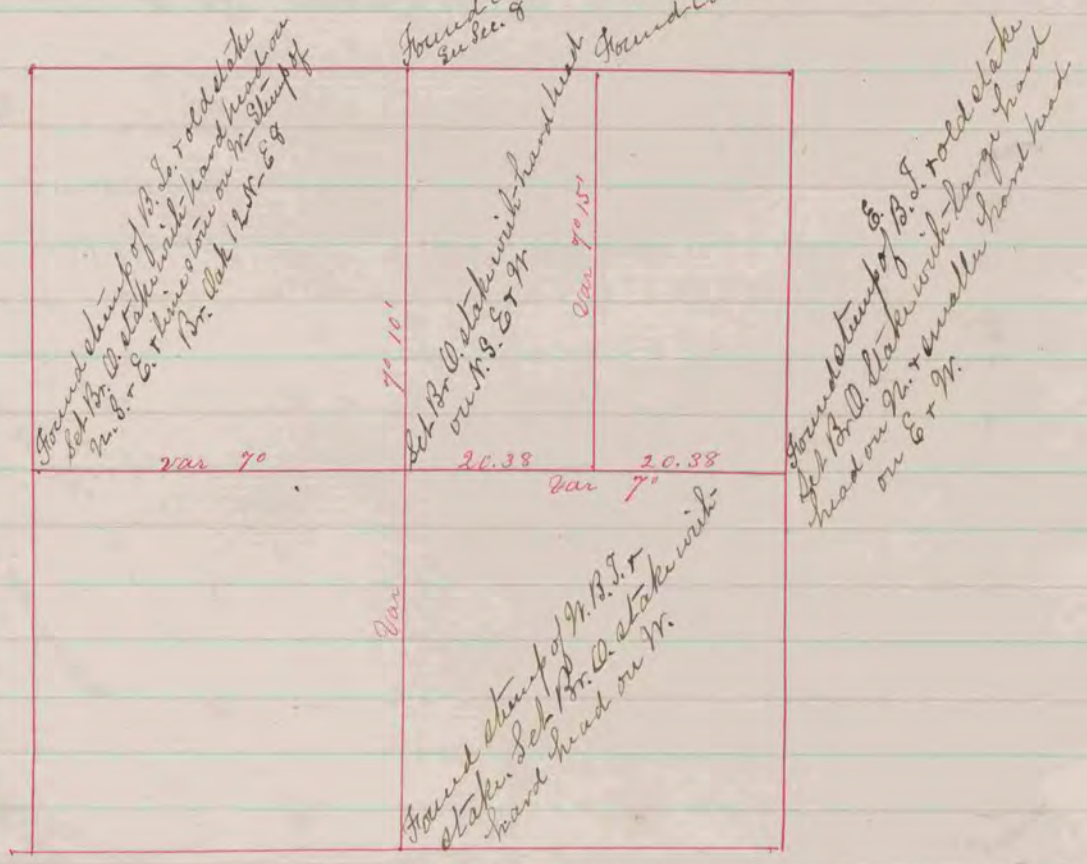

The above is a Correct Record & Plat of a Survey made by me May 4, 1868 on Sec. 17. Rock

S. D. Locke Co. Surveyor