COUNTY SURVEYOR
RECORD 1859-1906

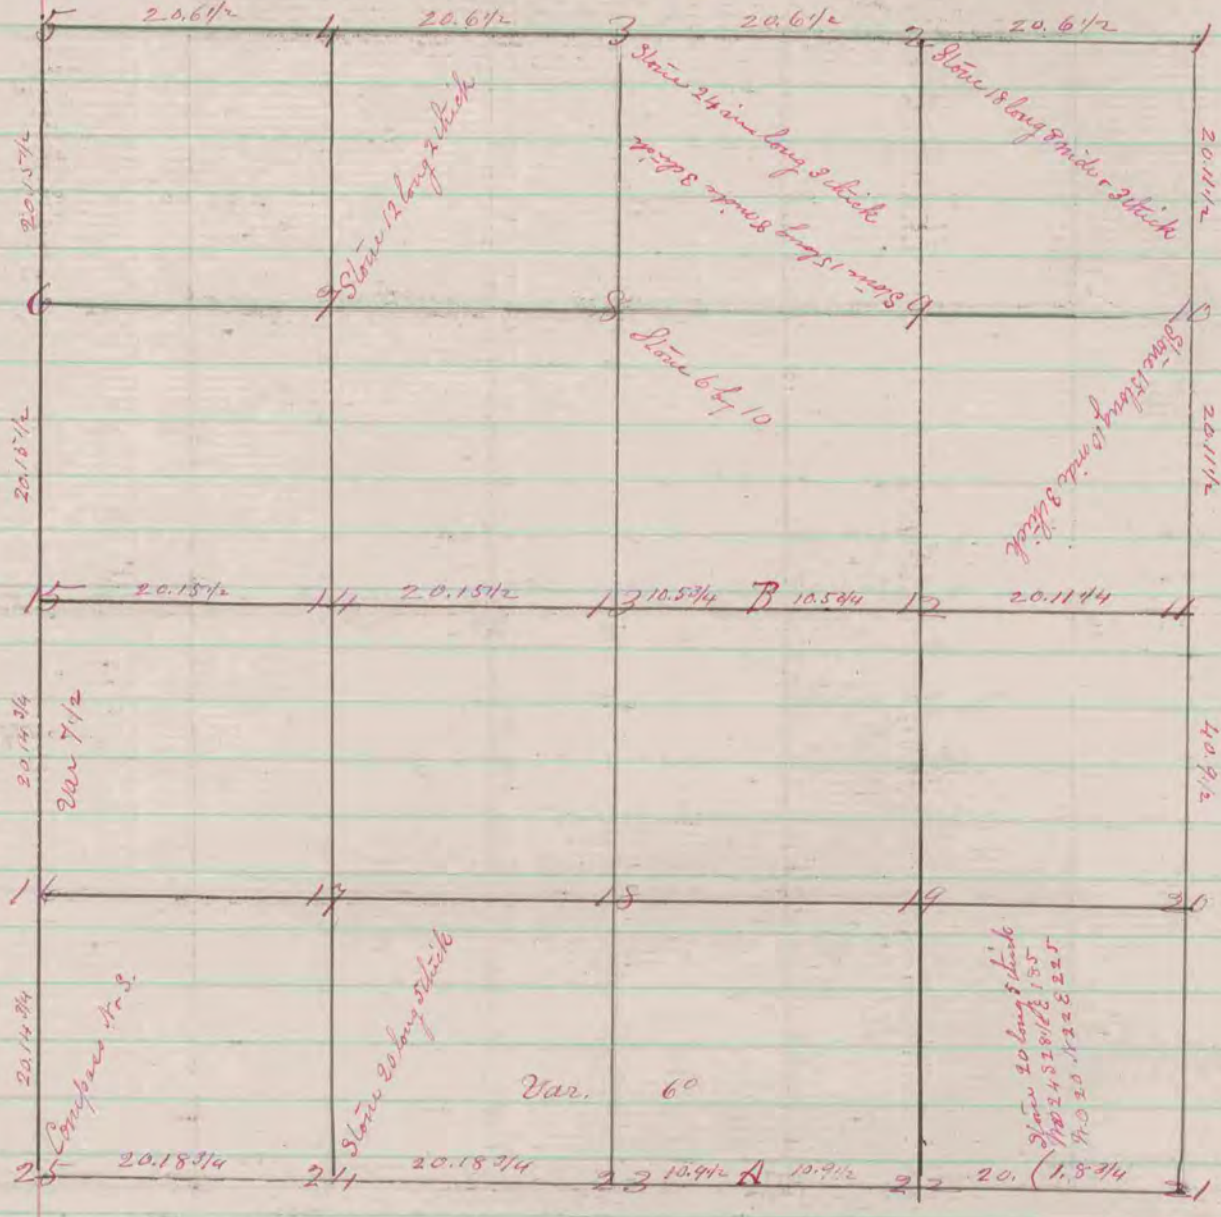

Fig 25 Stone 24 in. long 8 wide 4 thick School house S 6½ E 239
S.E. Cor. Jake Fishes house N W 151
21 Stone 12 in. long 3 in. thick
15 " 18 " " 4 " " 8 in. wide S. cor. house N 15½ W 536
Locust tree N 58 W 42
6 Stone 15 in. long 10 wide 3 thick
4 " 20 " " " " " "
Bl. O. N 54 E 203 Bl. O. N 54 W 220
5 Stone 18 in. long 6 in. thick. A Stone 20 in. long 6 in. thick
1 " 15 " " 8 wide 4 in. " B " 14 " " 8 wide 3 "
13 " " " " " " 8 " " Fig 8 Stone 10 " " 6 "
12 " 14 " " " " 6 " " 9 " 6 by 10
11 " 18 " " " " 24 " 20 in long 5 in thick
23 " 20 " " 5 in. thick Lewis Smiley's house N W cor
S 35¾ E 257¾ Locust tree 6 in. N 28½ W 44½

Joseph Church
County Surveyor

A Record of Plat of a Survey made on Sec. 28 T. 2. R 11 E.
May 25 & 26 1855 Plymouth

Joseph Church
County Surveyor