COUNTY SURVEYOR
RECORD 1 1851-1869

A Survey on Sec 19 T 1 N R 13 E.
Surveyed May 31st 1859 by
E T Hobart Deputy County
Surveyor

Surtle

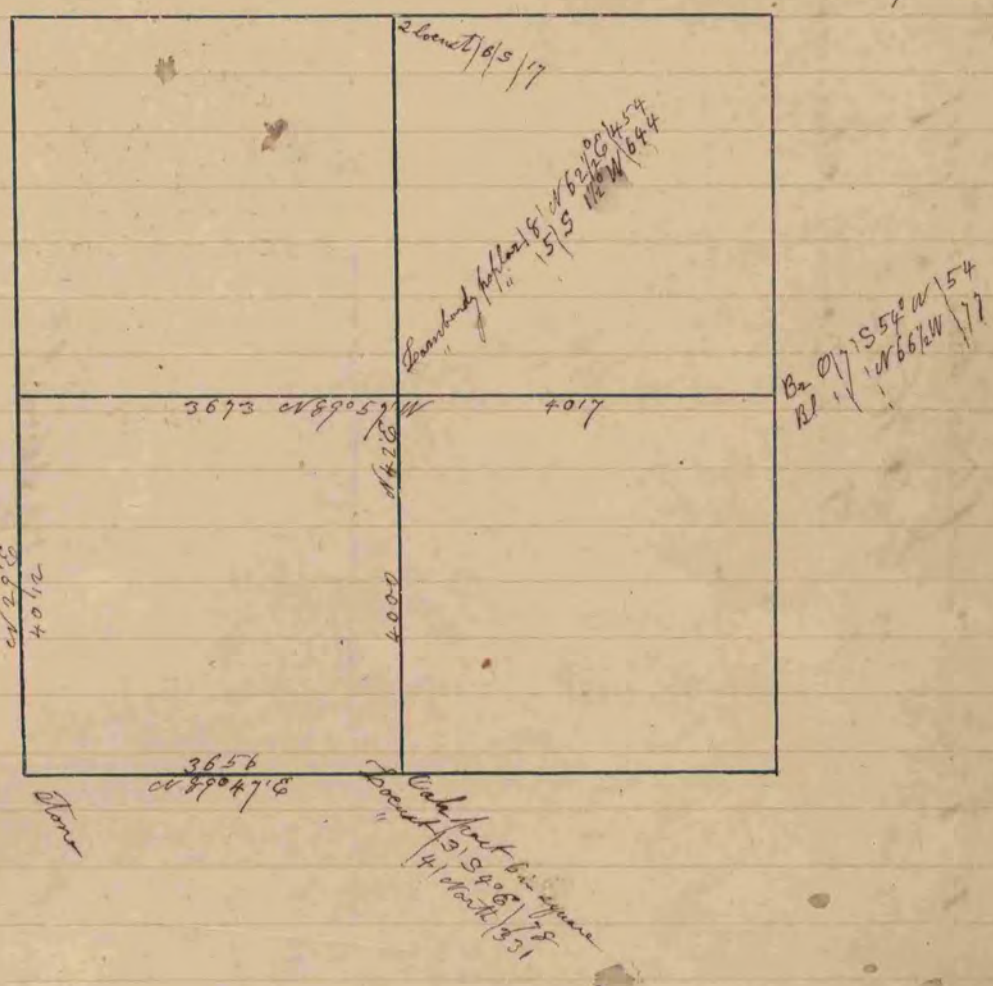

Courses according to the true Meridian
Variation 5°30'
Measurement in links
Note of Bearing Trees established at the time of the survey are given on the plat