COUNTY SURVEYOR
RECORD 1 1851-1869

Of record and plat of a survey made between town three
Range ten East

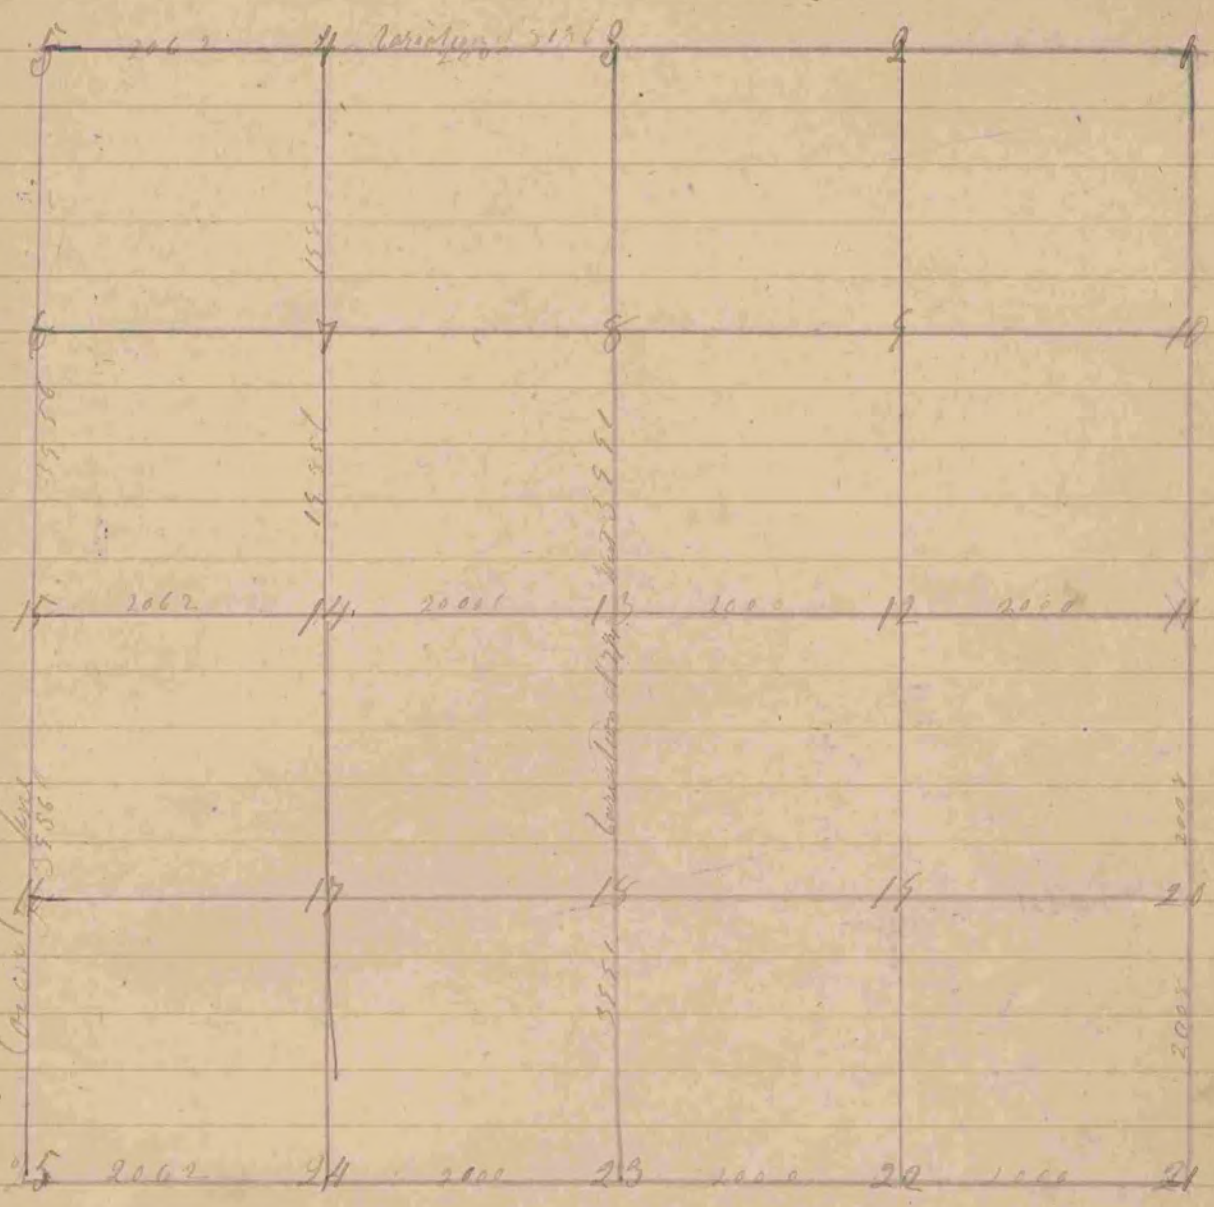

Fig 13 Centre of Sec Wit-Br C 16 & 15 N 75 E
17 N 23 N 56½ "
S 1 60 ¼ E 117 "
F B. no bearings made Corner Br C 10 & 15 N° 25 W° 25 E
& & 25 E 182 "

11 found Stones 4 to 6 feet
21 bus Standing
The above survey was made by C. H. Church & B. of Sec 1853
Joseph Church County Surveyor
