#3

A Record and plat of a survey made on Sec 8
Town Two Range Ten East

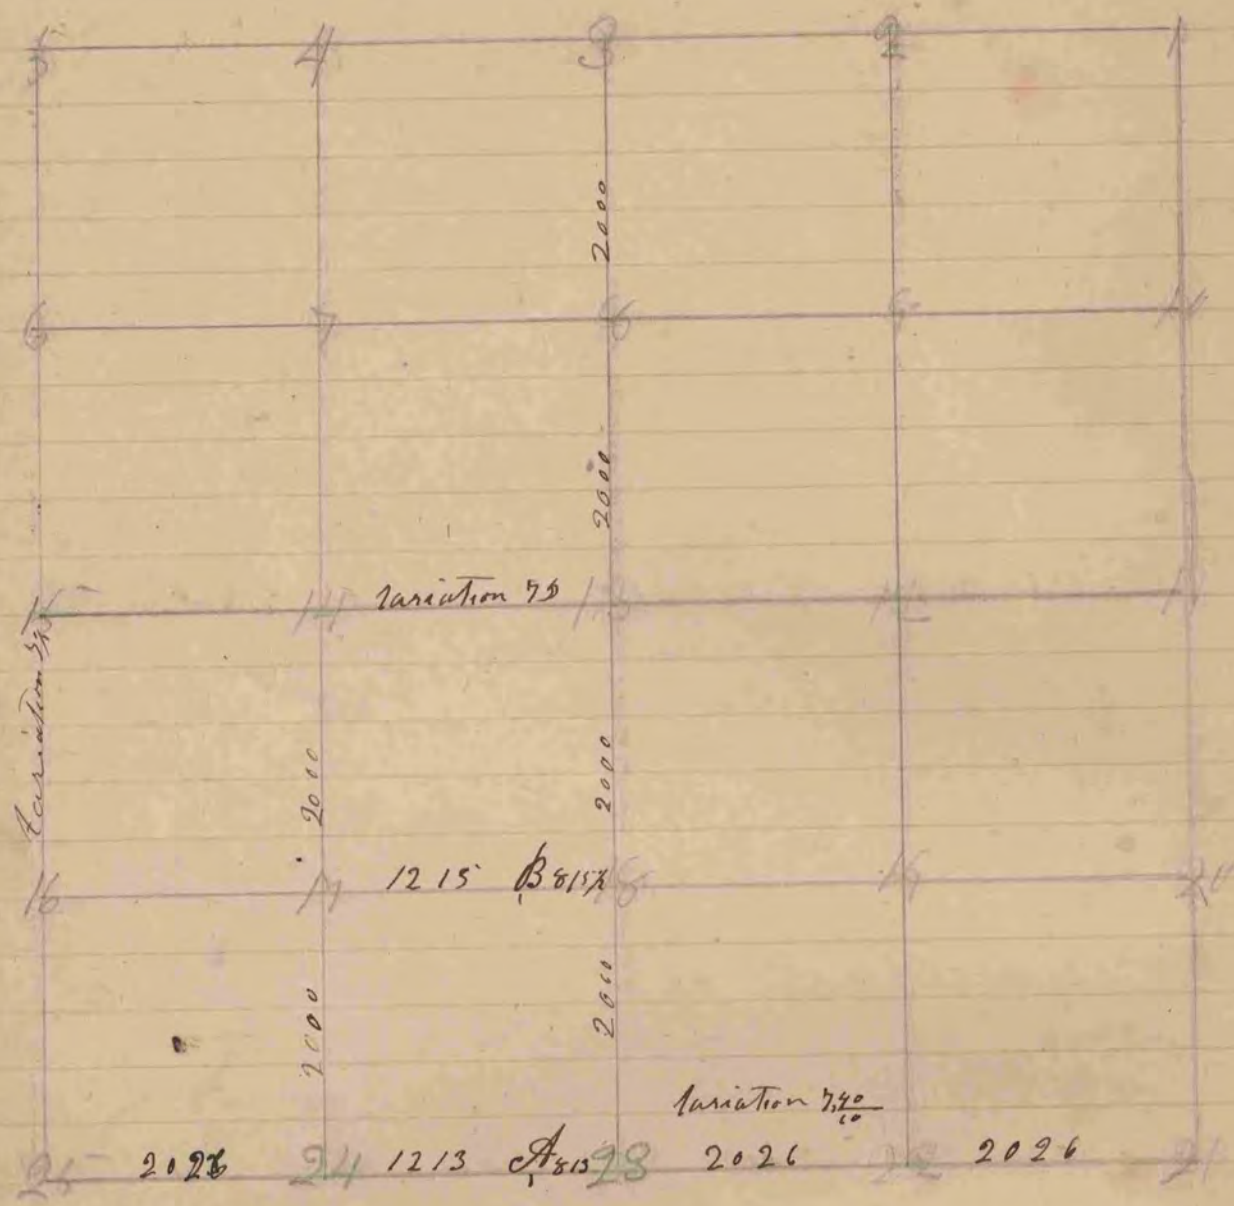

Fig 13 Bur O 24 S 59½ E 200 links
= 16 S 28½ E 115 =
B = 24 N 48 W 684 =
14 N 25 W 395
A = 18 S 12 E 7.56
= 16 S 49½ E 112
= 23 Bur O S 59 W 48 =
20 S 17½ W 87
= 18 Bur O 20 N 14½ W 25
20 S 81 W 17
17 = 20 S 51 E 57
= 24 N 26 W 58
8 = 24 S 63 E 135
= 18 S 19 W 66

The above survey was made on the 6 & 7 day of June 1855
Joseph Church County Surveyor