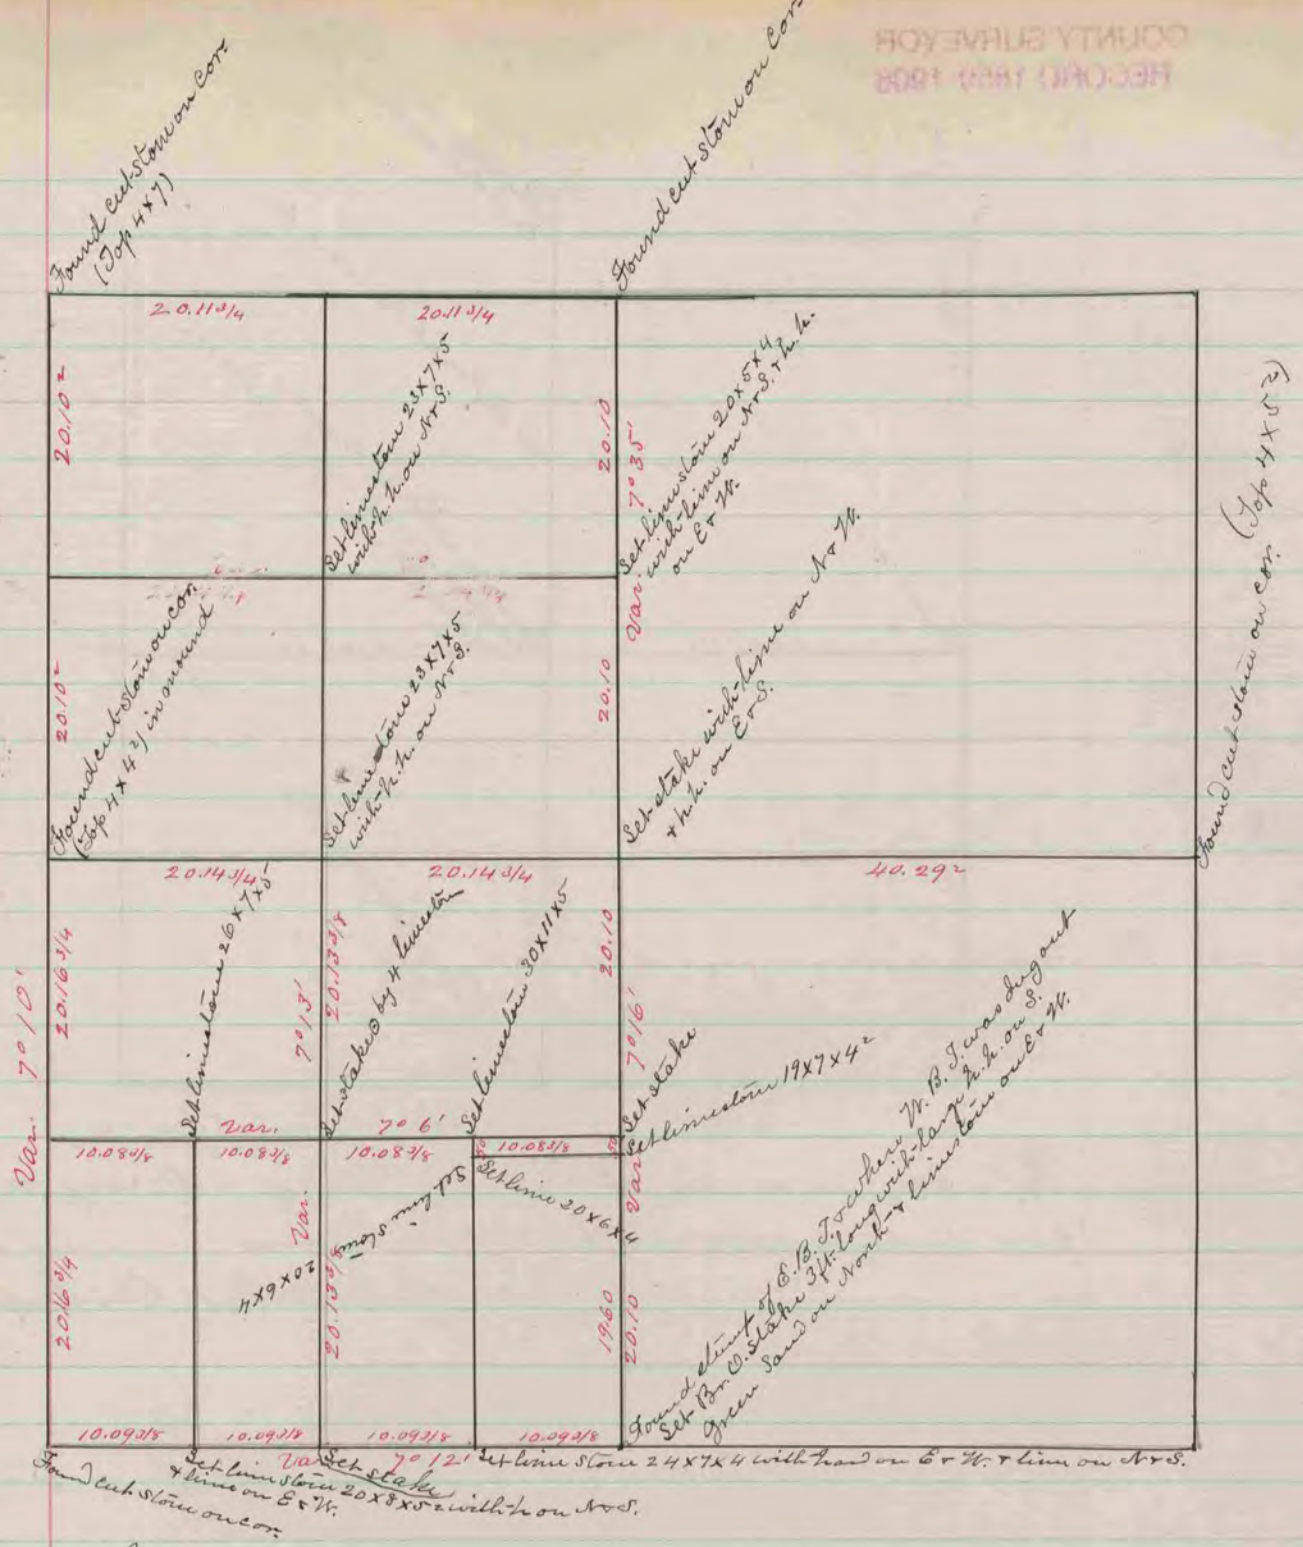

Center 232

The above is a correct Record & Plat of a survey made by me on Sec. 27, Center, May 29. 1866. S. D. Locke Co. Surveyor

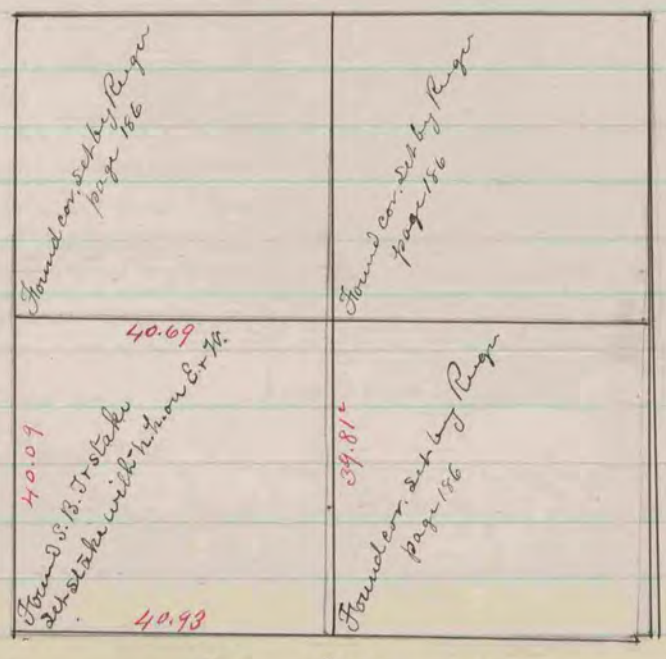

COUNTY SURVEYOR
RECORD 1859-1906

Linn 235

The above is a correct Record & Plat of a survey made by me July 12, 1866 on Sec 22. Linn S. D. Locke Co. Surveyor