COUNTY SURVEYOR
RECORD 1 1851-1869

247

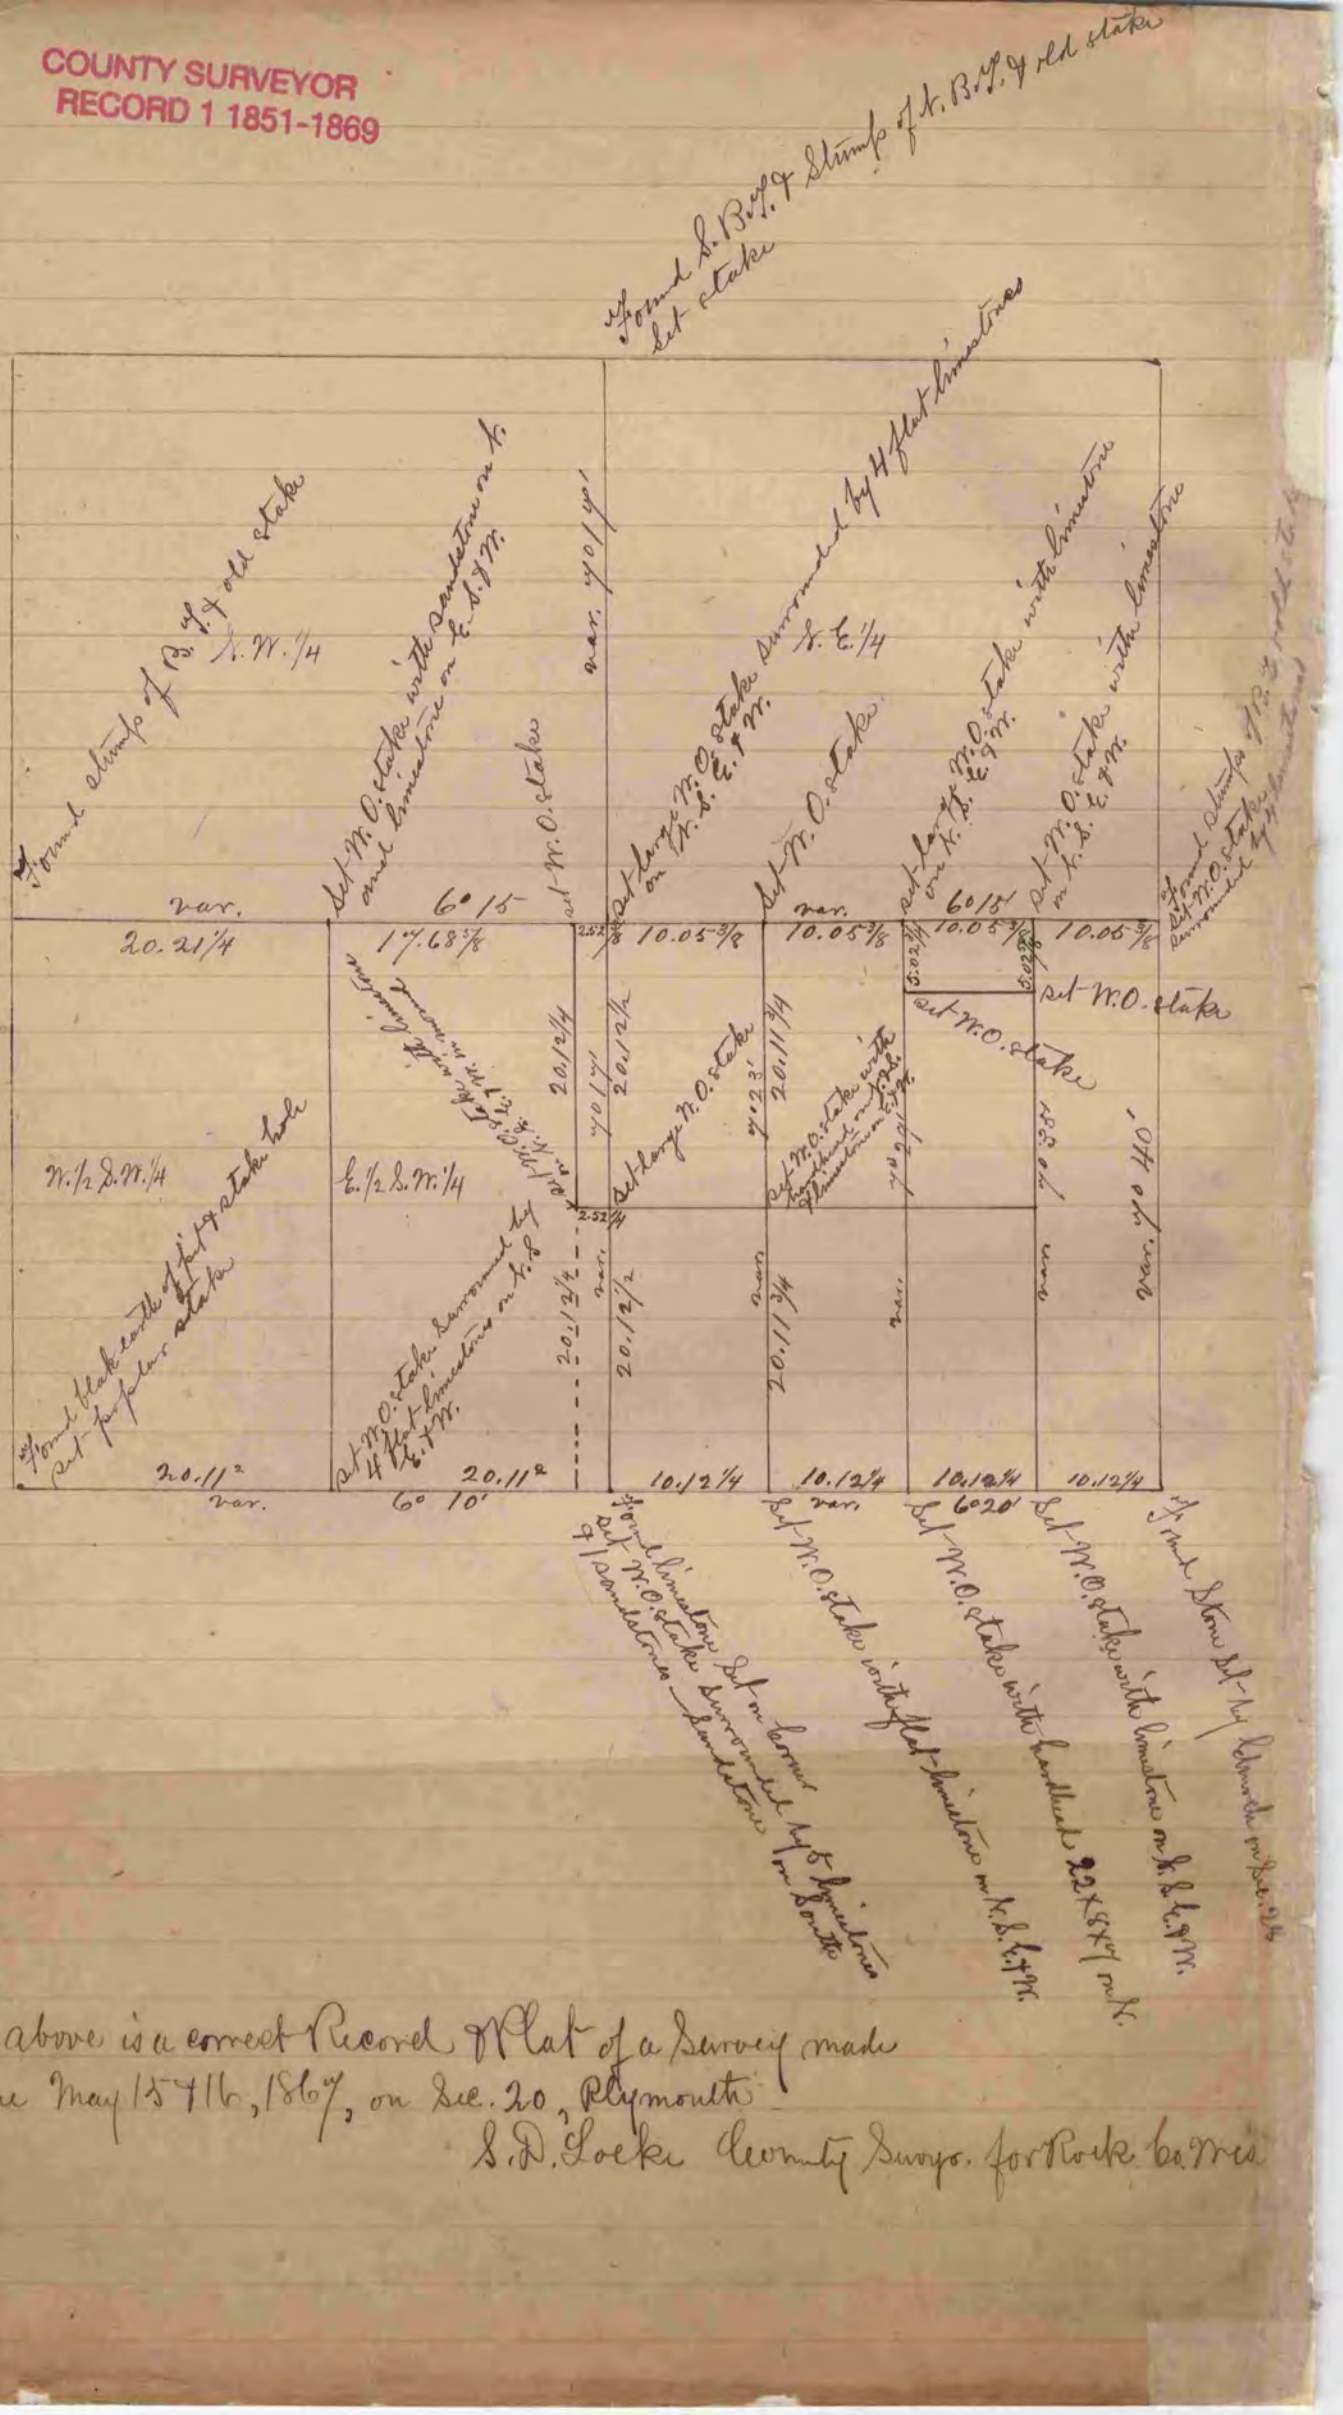

The above is a correct Record Plat of a Survey made by me May 15 & 16, 1867, on Sec. 20, Plymouth

S. D. Locke County Surveyor for Rock Co. Wis.