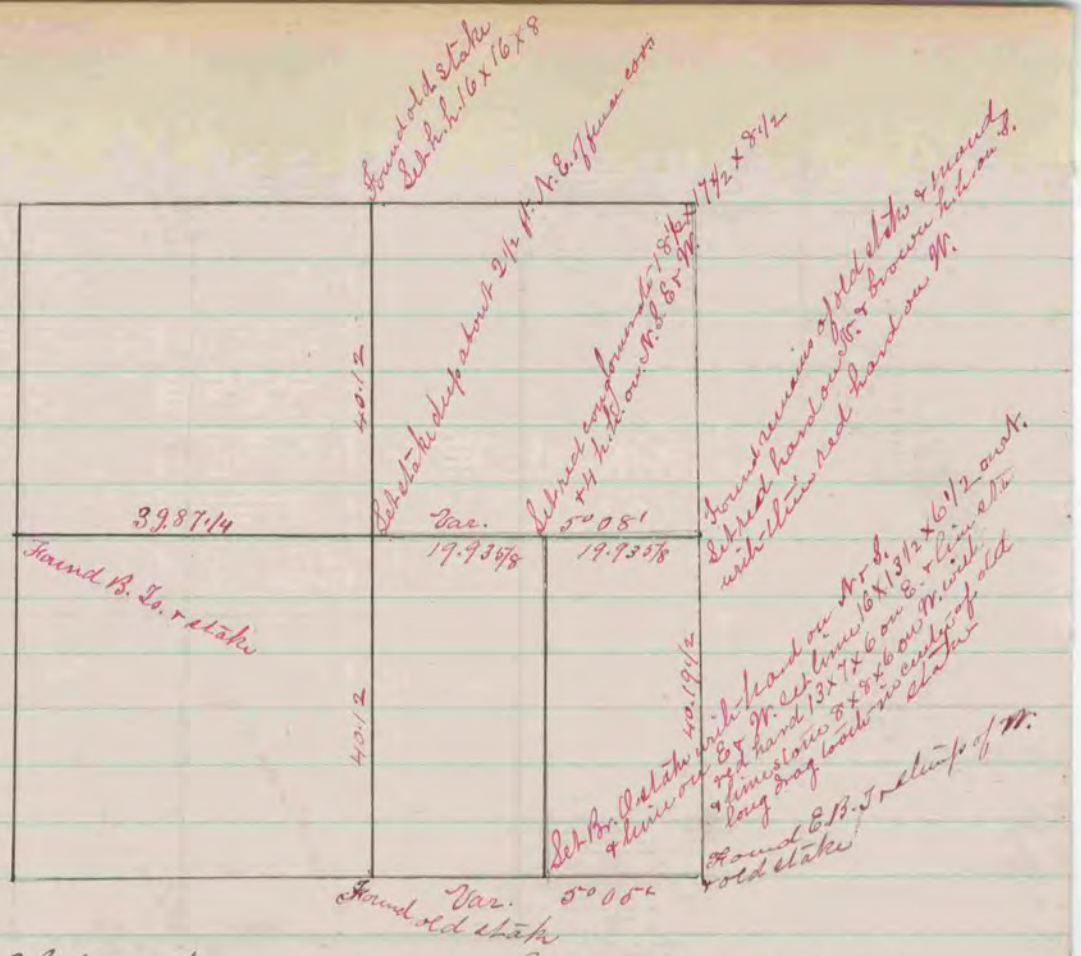

Record & Plat of a Survey made on Sec. 33. T. 4. N.R. 13 E.
June 20 & 21. 1864. by S.D. Locke Co. Surveyor
Millon

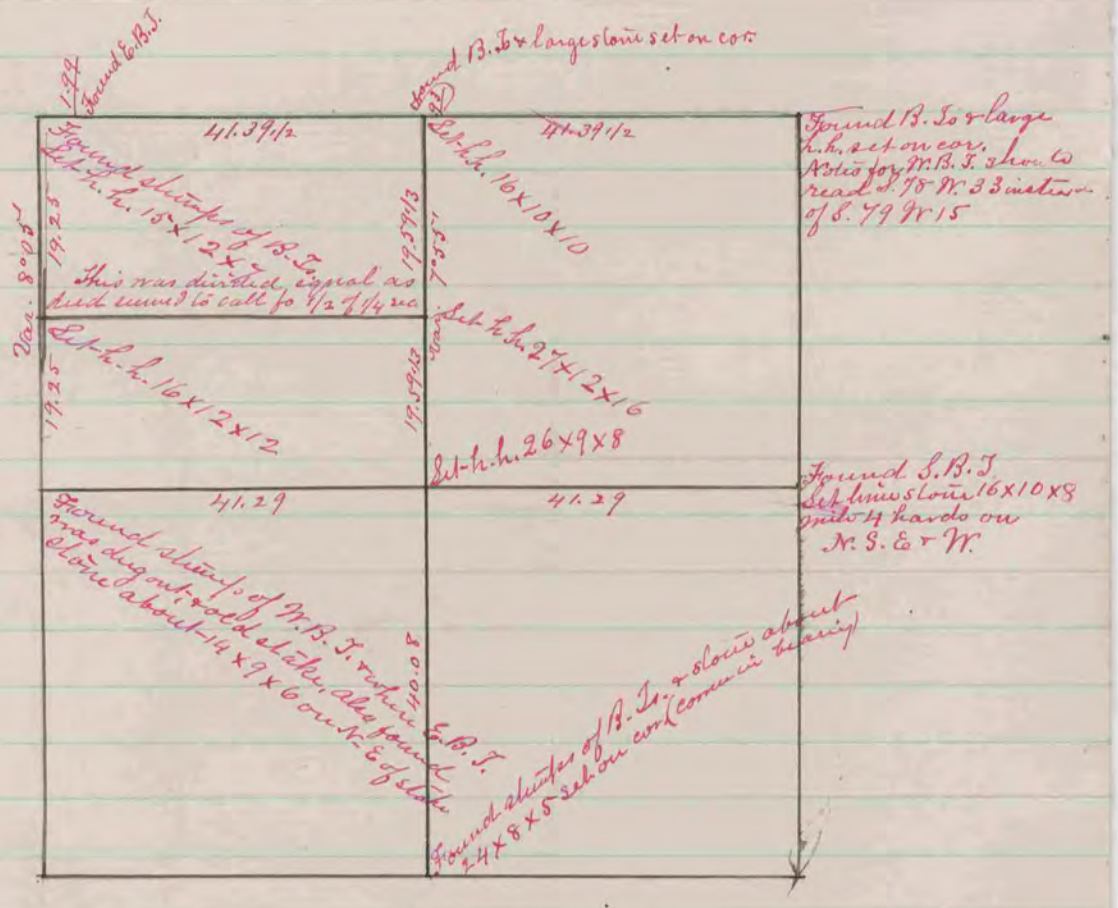

Center 208

Record & Plat of a Survey made on Sec. 1. T. 3. N. R. 11. E.
by S.D. Locke Co. Surveyors Center

COUNTY SURVEYOR
RECORD 1859-1906