COUNTY SURVEYOR
RECORD 1859-1906

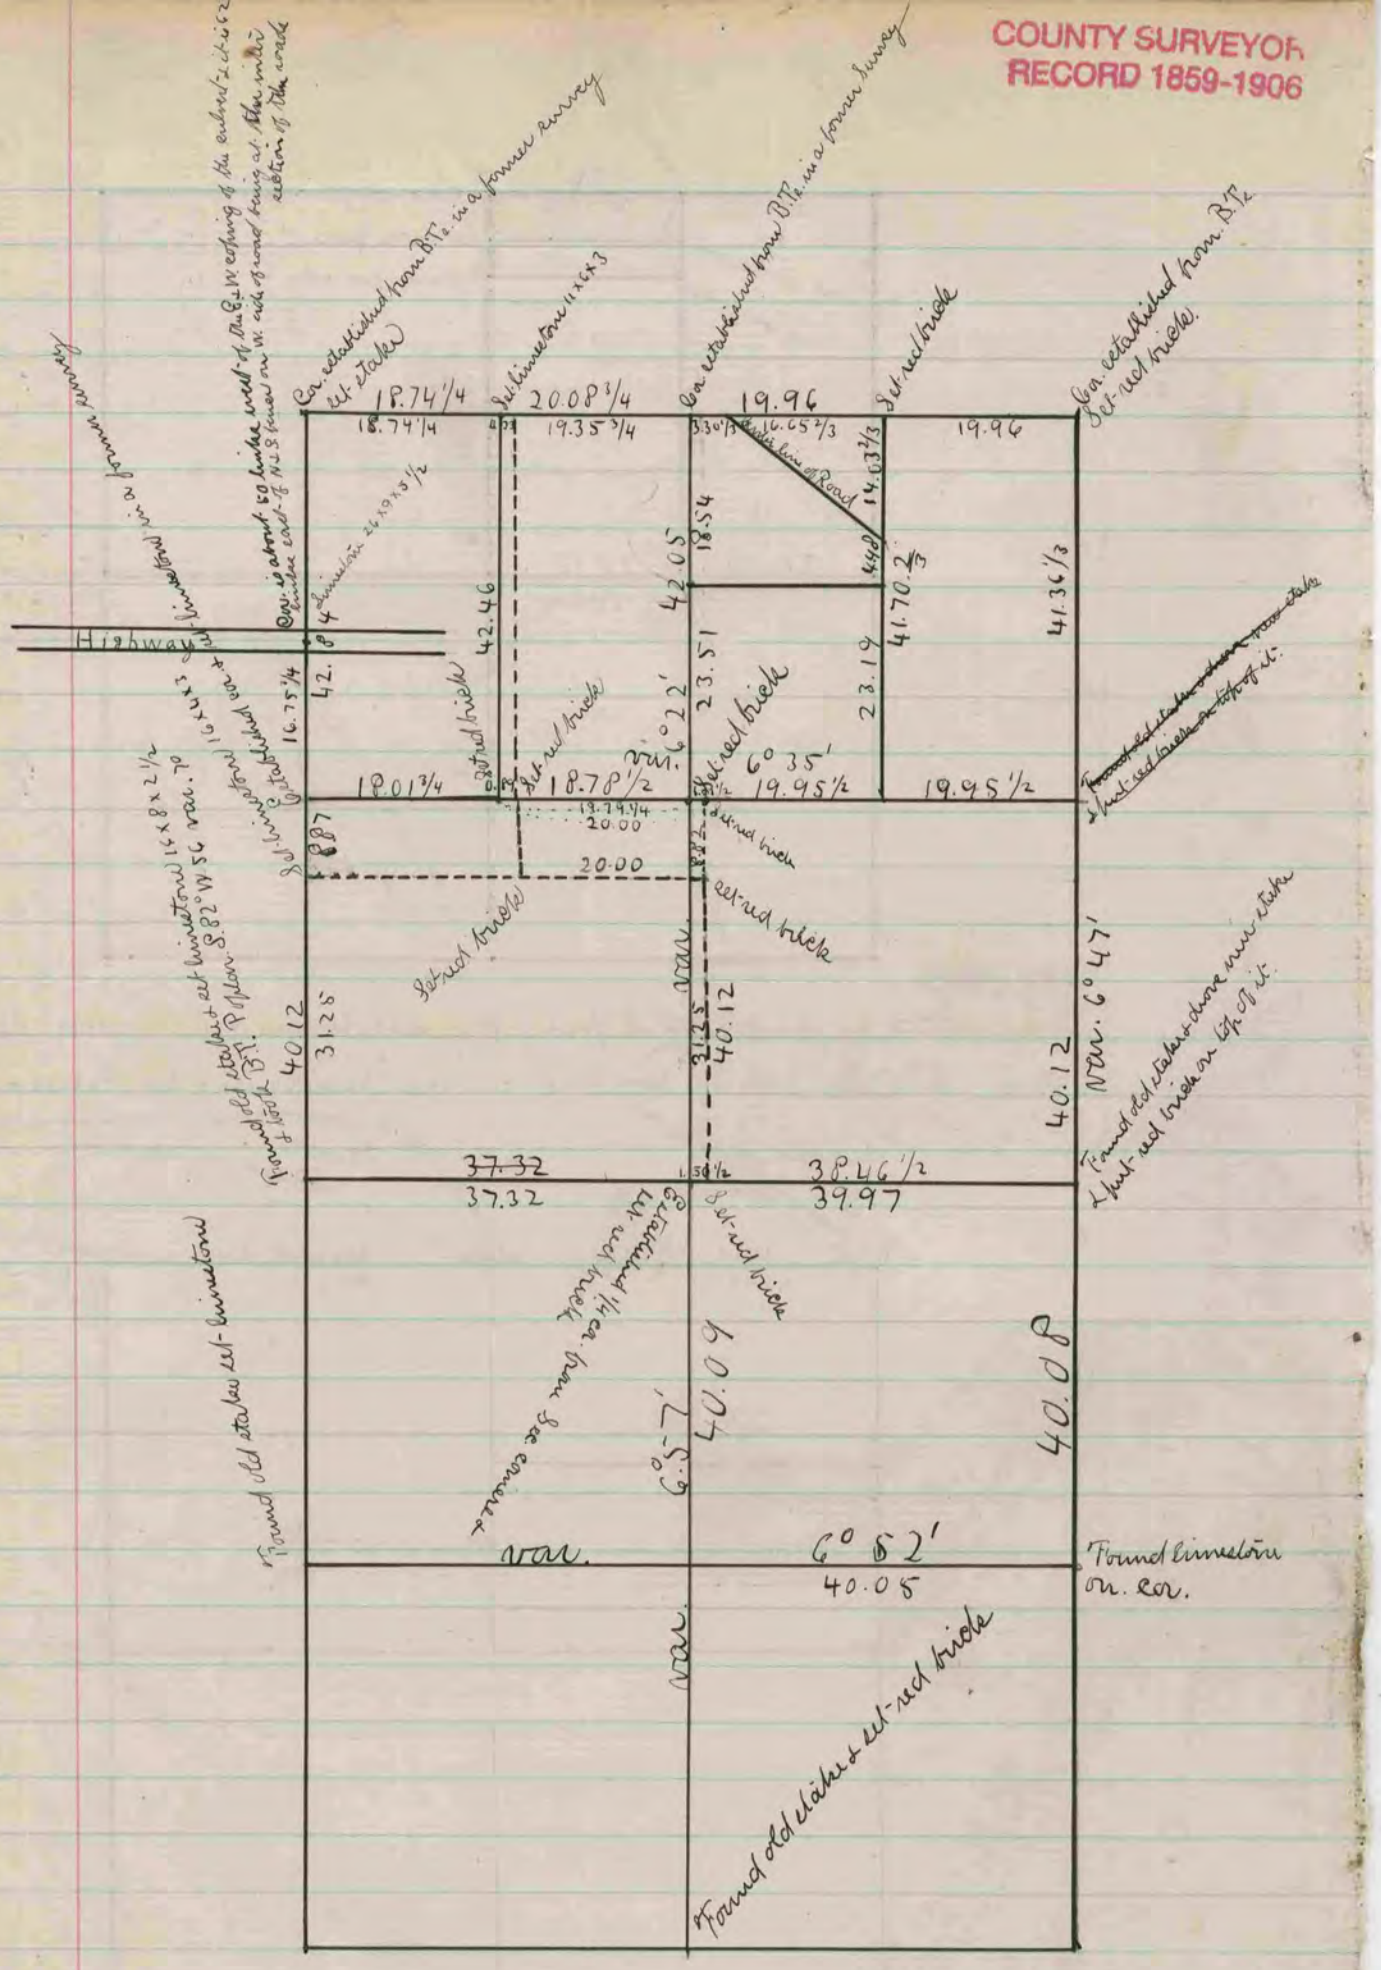
Highway
Found old stakes & set limestone
Found limestone cor.
Set limestone
Set red brick
Set red brick
Set red brick