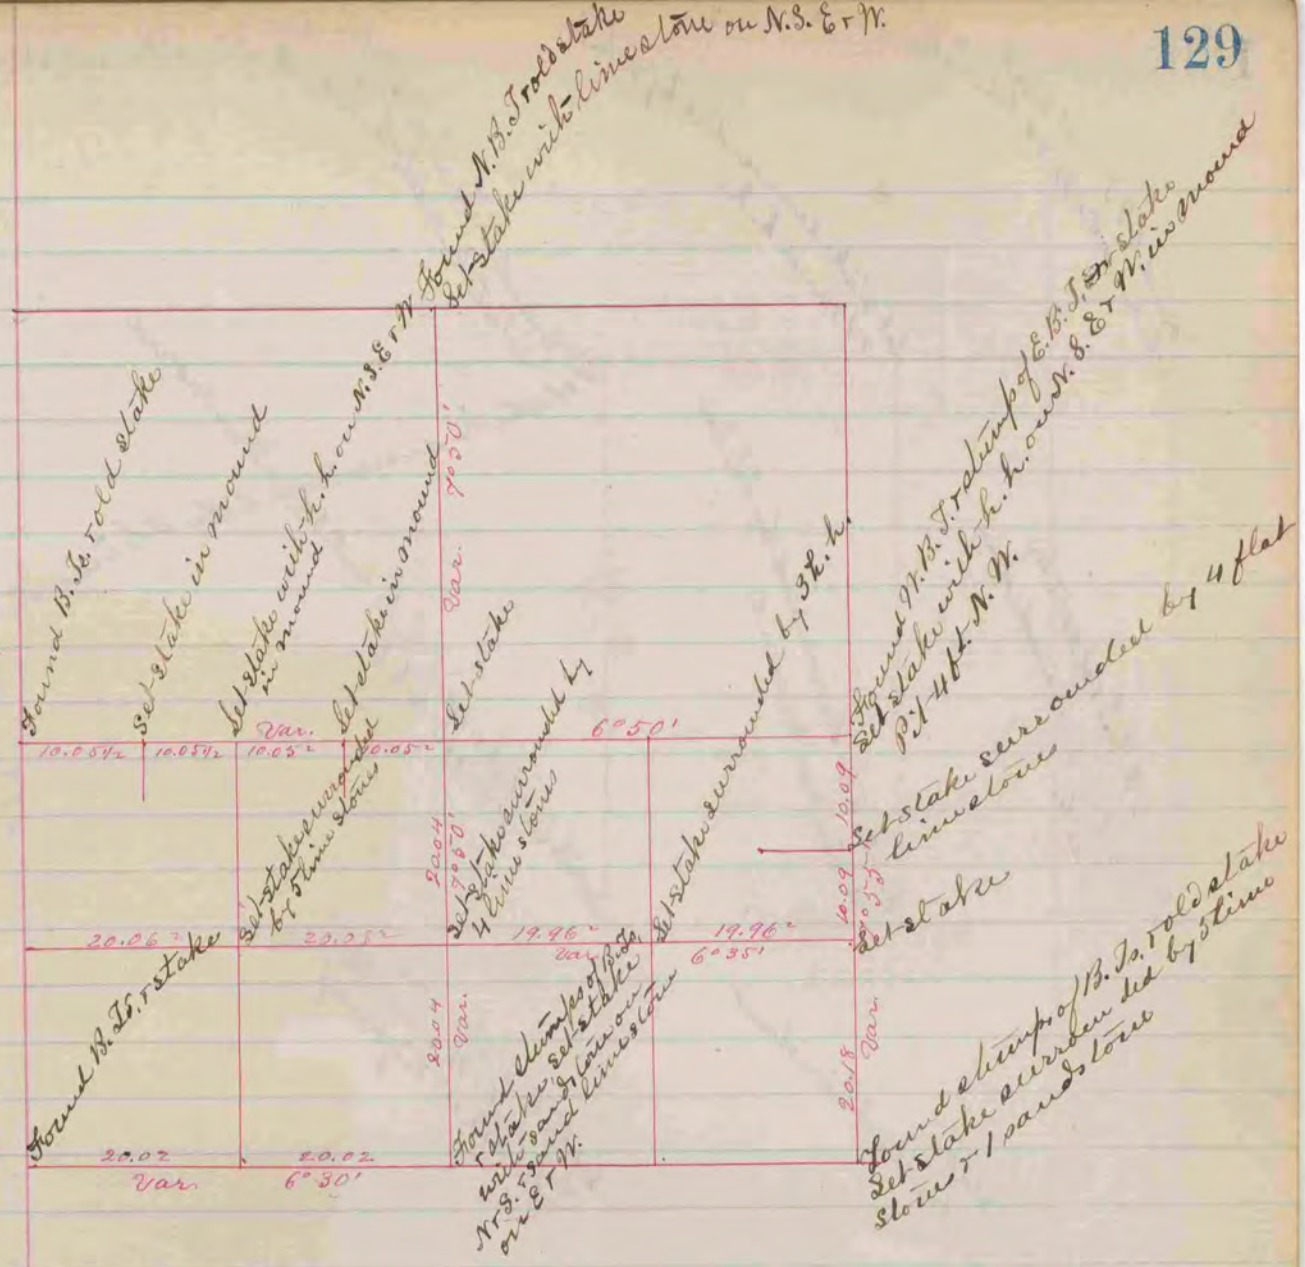

The above correct Record & Plat of a Survey made by me Oct. 1 & 2, 1867 on Sec. 27 Spring Valley

S. H. Locke Co. Surveyor

COUNTY SURVEYOR
RECORD 1859-1906