COUNTY SURVEYOR
RECORD 1 1851-1869

A plat of a Survey made on Section twenty Seven in the Town of Avon. Town one. Range ten.

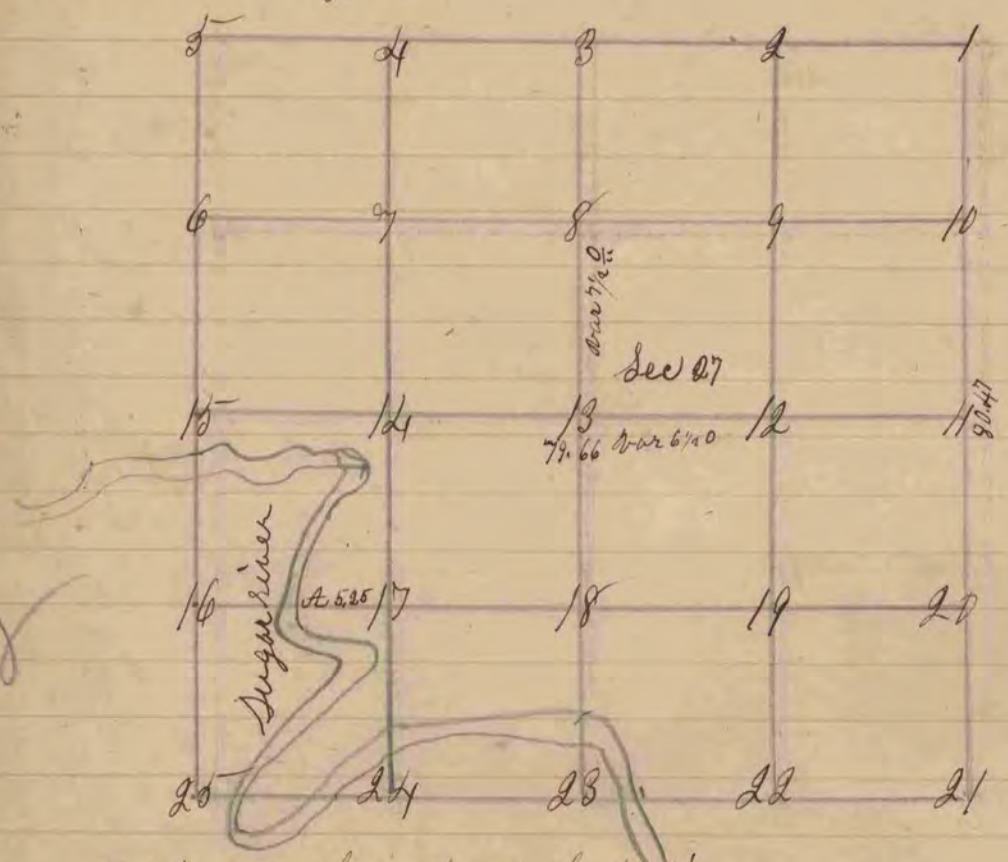

figuer 13 represents the centre of the Section
fig 13 buried a lime Stone 24 inches long 12 wide and 5 thick even with the surface of the ground
fig 14 buried a lime Stone 15 inches long 6 wide and 5 thick even with the Surface
" 15 buried a round hard head Stone 15 inches in diameter in the ground even with the surface
" 18 buried a lime Stone 18 inches long 15 wide and 5 thick the top 4 inches above the surface
" 17 buried a lime Stone 20 inches long 12 wide and 5 thick. 4 inches the top above the Surface
" 20 buried a hard head Stone 15 inches long 12 inches in
" 1 diameter even with the surface of the ground
" 11 buried a lime Stone 24 inches long 18 wide 6 thick the top 4 inches above the Surface
Letter A Represents a post on the line of forties and on the East Bank of Sugar River. the bearing trees as follows
Letter A Elm 12 S 39 W 34 also Elm 10 N 16 E 68 and is West of fig 5.25
The above Survey was made June 4th 1854
Peter McLean County Surveyor