COUNTY SURVEYOR
RECORD 1859-1906

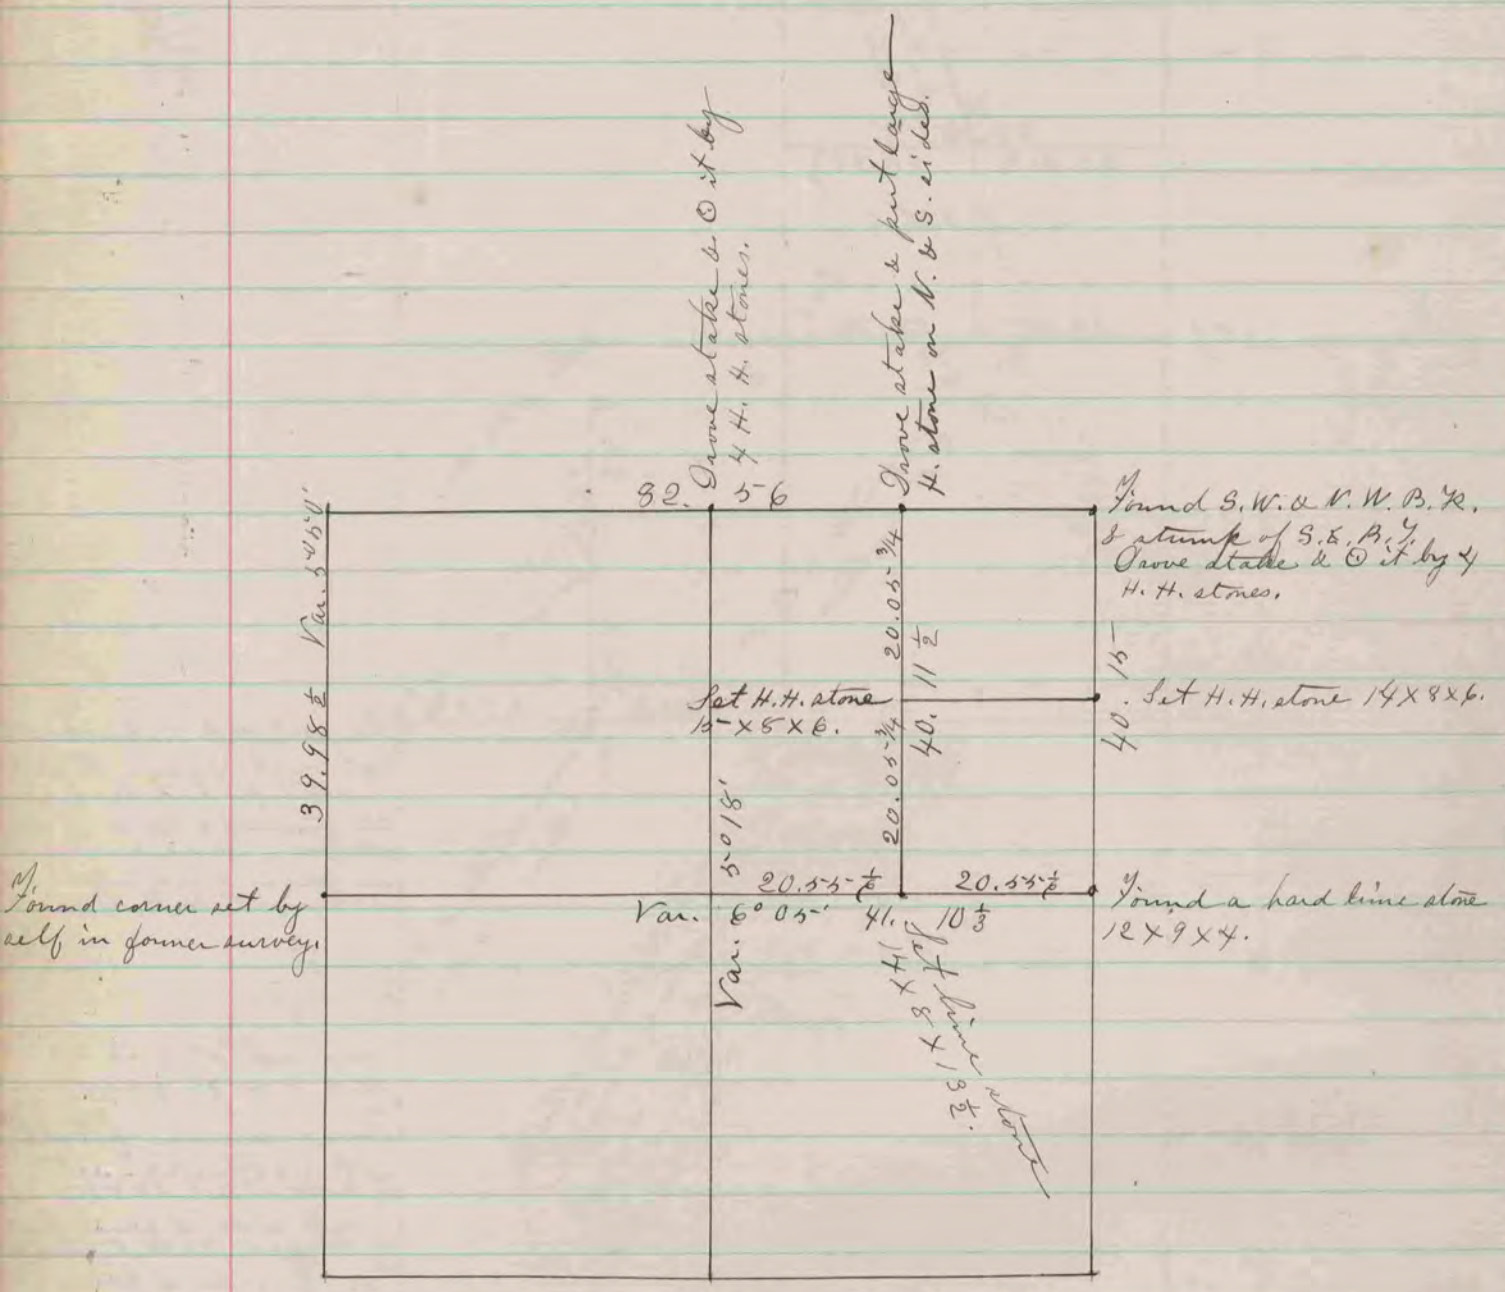

The above is a record and plat of a Survey made by me on Section 23 Porter - June 13 th 1883

Edward Ruger
County Surveyor.

COUNTY SURVEYOR
RECORD 1859-1906