265

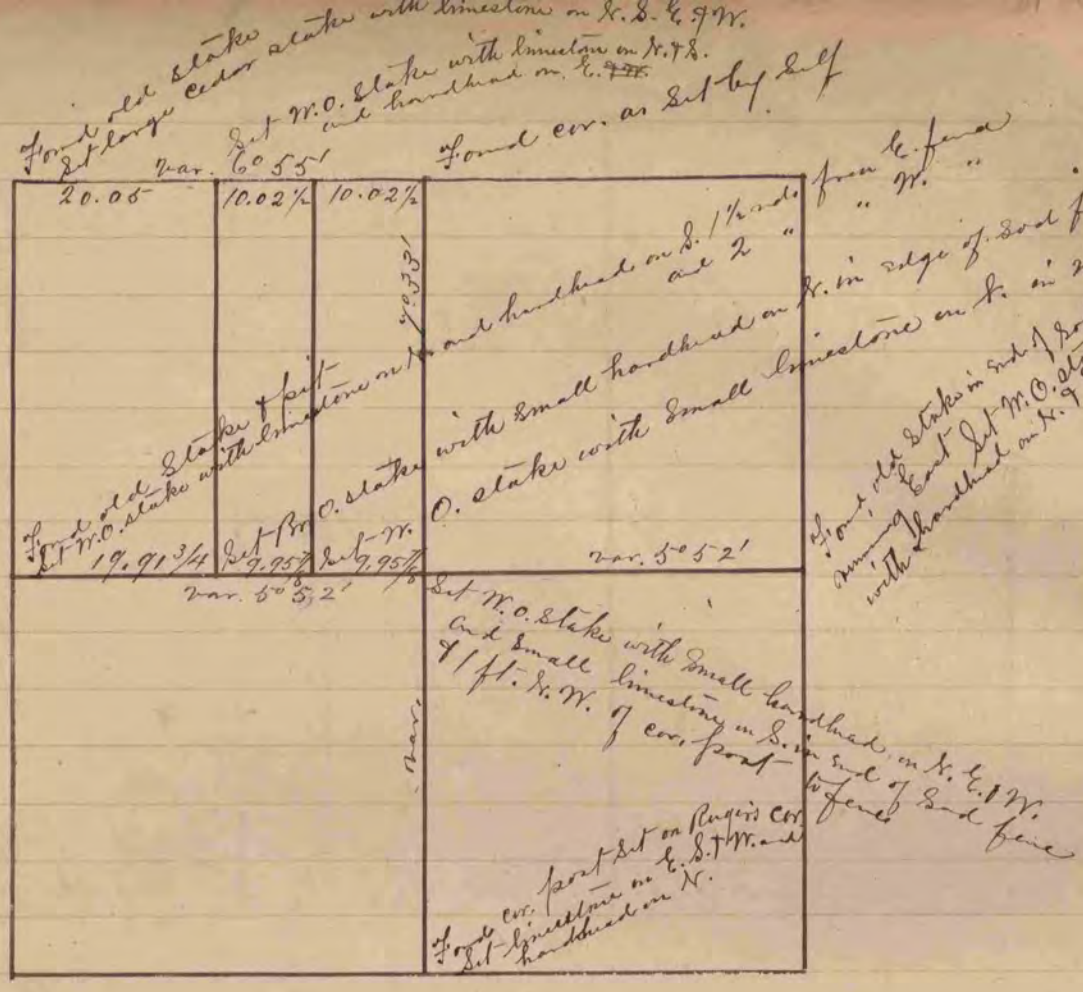

"The above is a correct Record Plat of a Survey made by me April 1st, 1868 on Sec. 27. Harmony
S. D. Locke County Surveyor

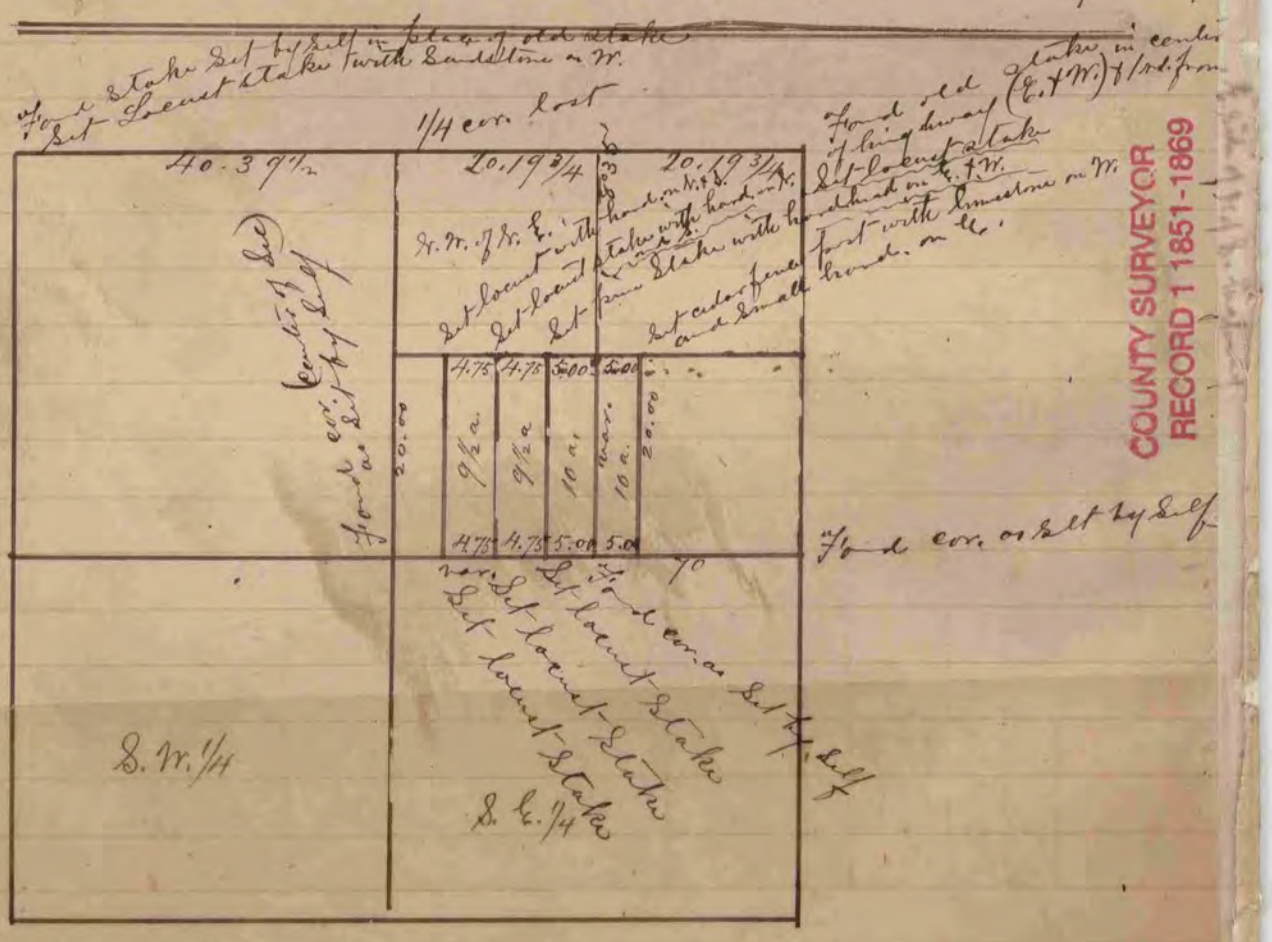

"The above is a correct Record Plat of a Survey made by me Apr. 20, 1868 on Sec. 34, Jonesville
S. D. Locke County Surveyor

COUNTY SURVEYOR
RECORD 1 1851-1869