215.

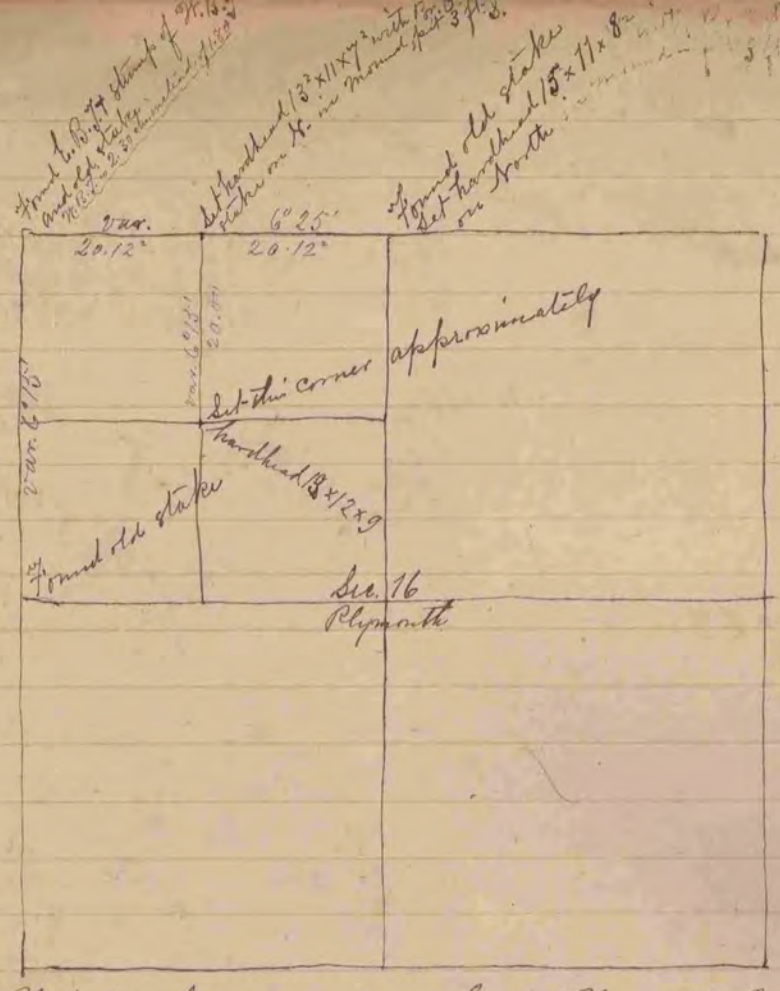

A Record & Plat of a Survey made on Sec. 16, Plymouth, March 31, 1865 by S. D. Locke, Co. Surveyor in and for Rock Co. Wis. Plymouth

COUNTY SURVEYOR
RECORD 1 1851-1869

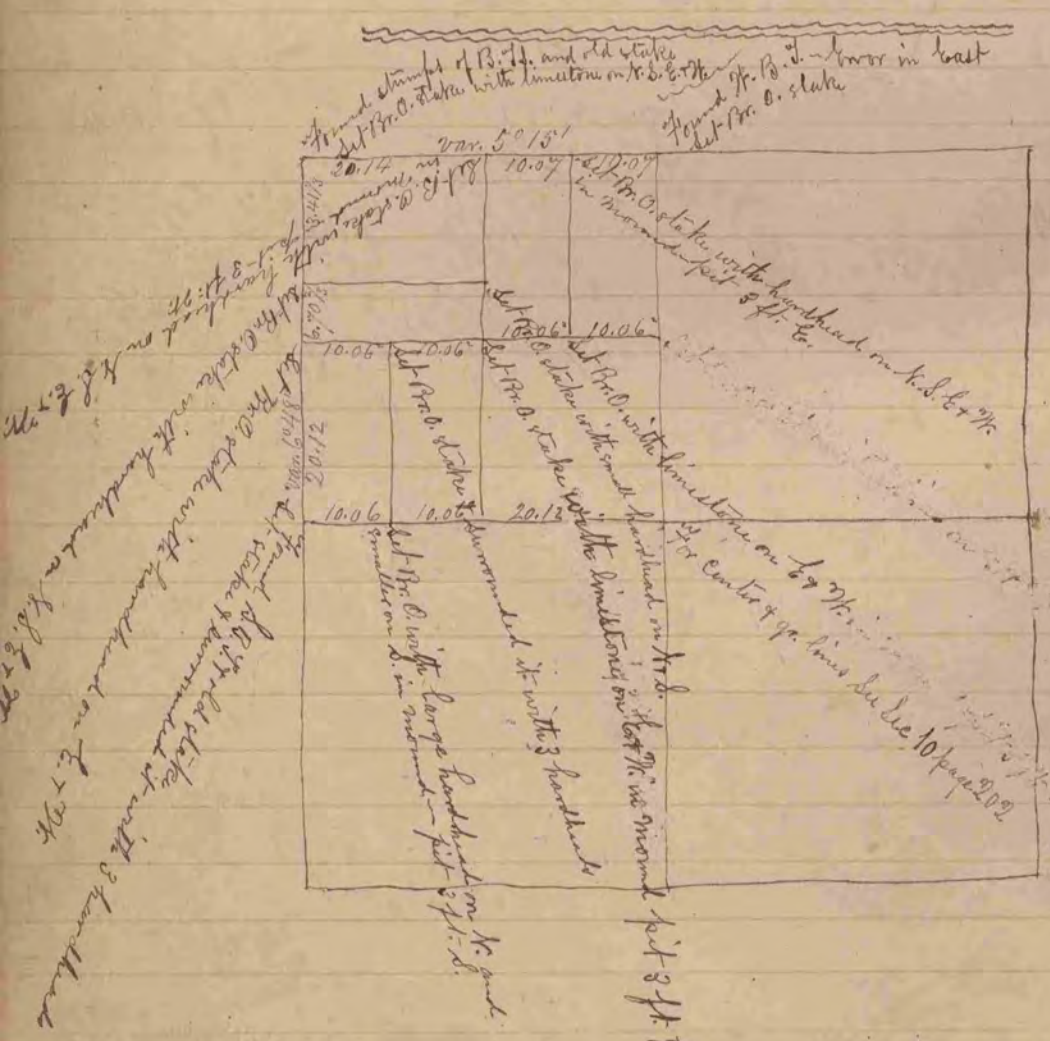

A Record & Plat of a Survey made on Sec. 10 Turtle, April 20 1865 by S. D. Locke Co. Surveyor in & for Rock County Wis.