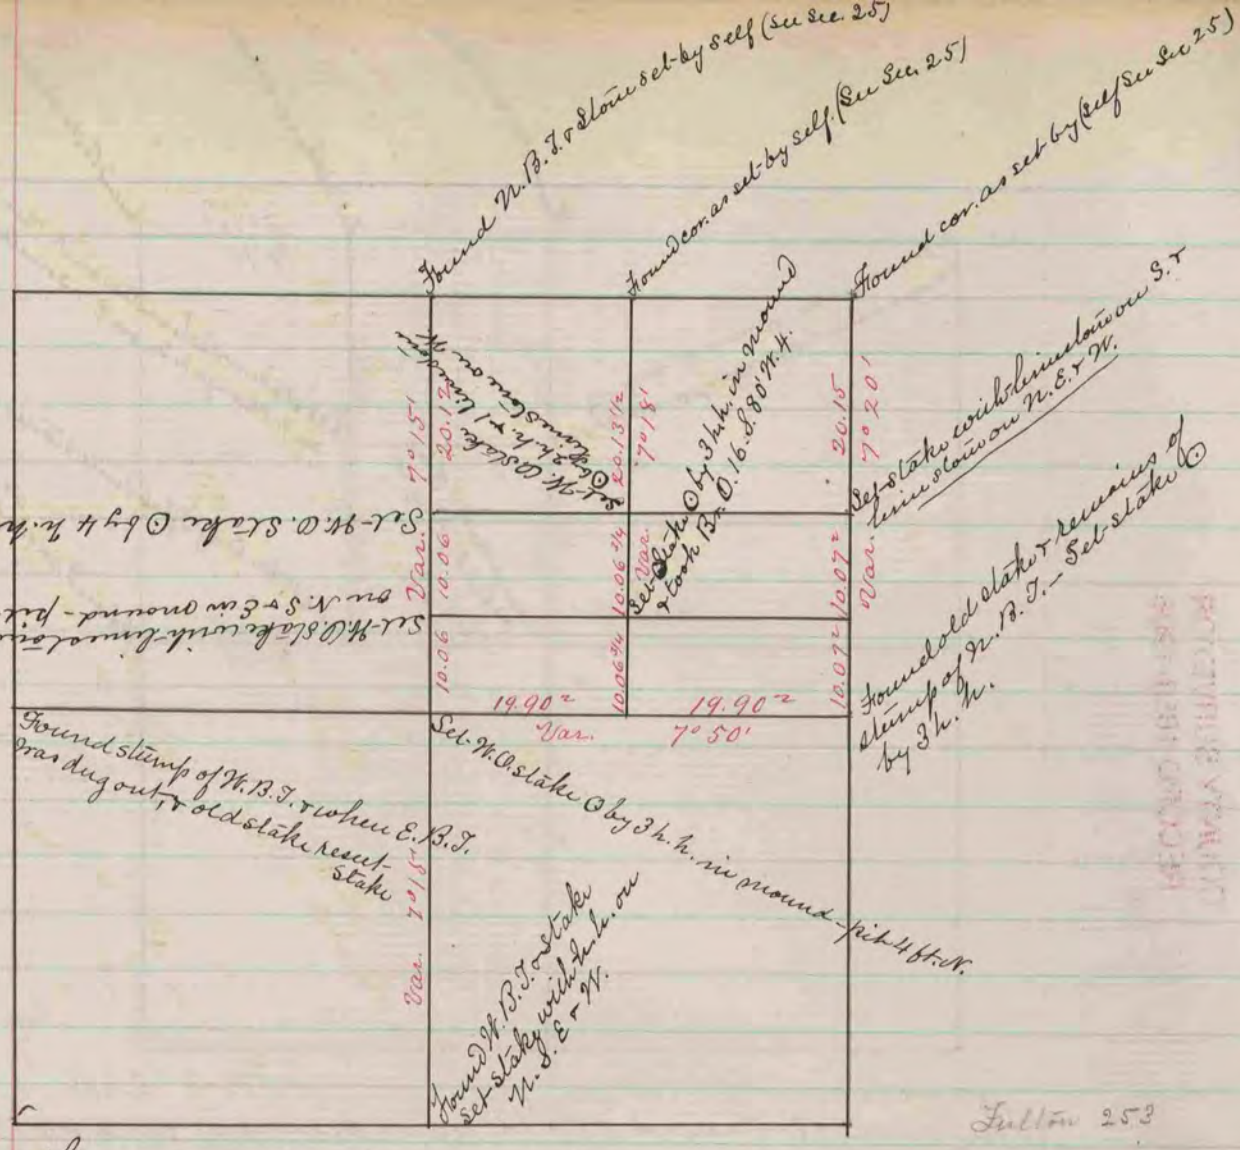

This is a correct Record & Plat of a survey made ~~by~~ by me Oct. 24. 1867. on Sec. 36 Fulton.

S. D. Locke Co. Sur. Rock Co.

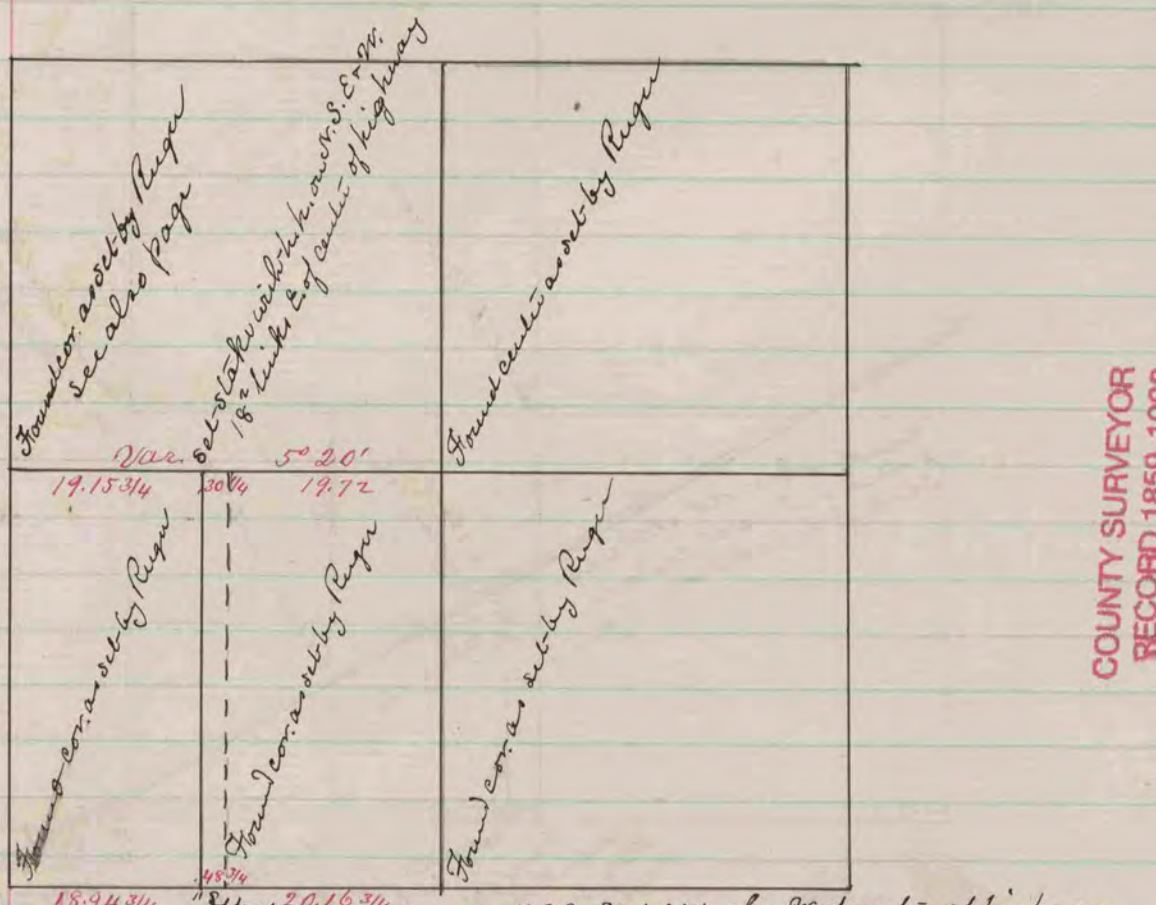

Bradford 253

The abov is a correct Record & Plat of a survey made by me Oct. 26, 1867 on Sec. 31. Bradford

S. D. Locke Co. Sur. Rock Co.

COUNTY SURVEYOR
RECORD 1859-1906