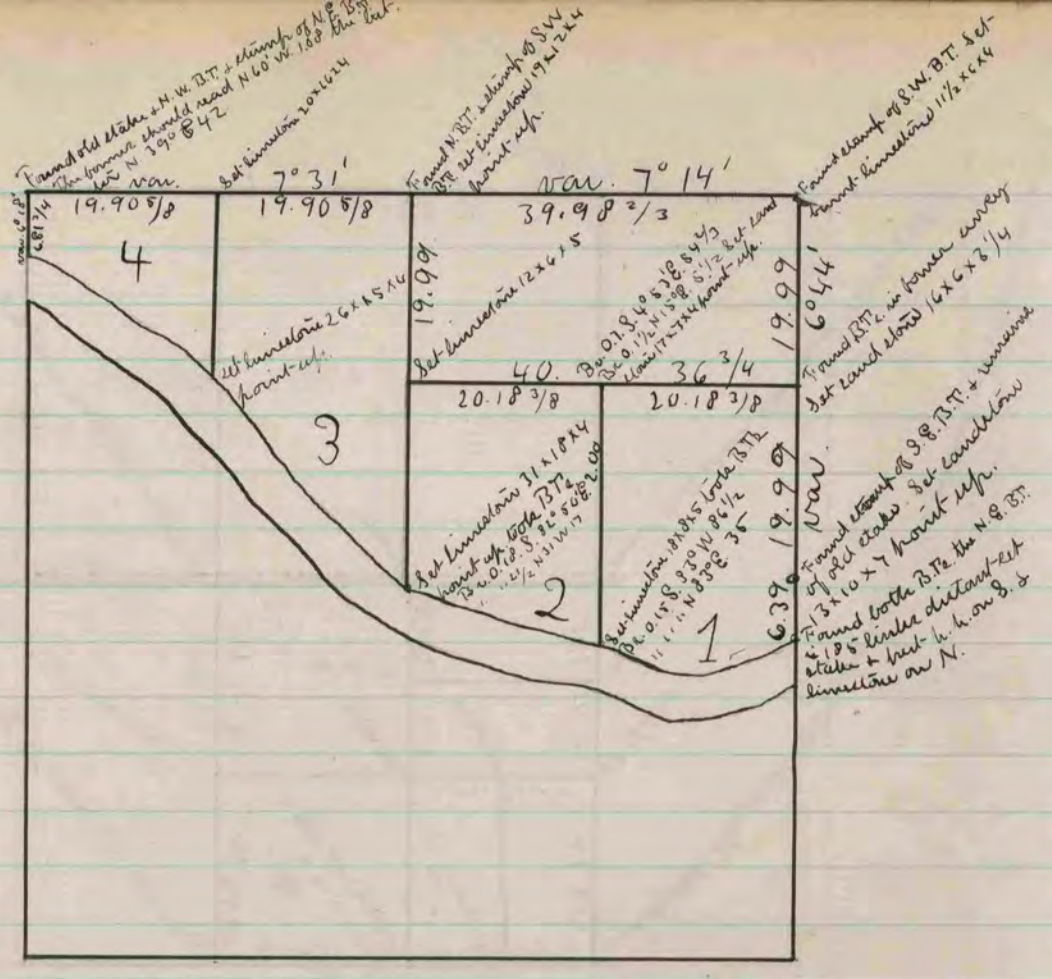

The above is a plat & record of a survey made by me Jan. 18. 19. 20 & 21, 1871 on Sec. 15. Fulton

Edward Ruger County Surveyor

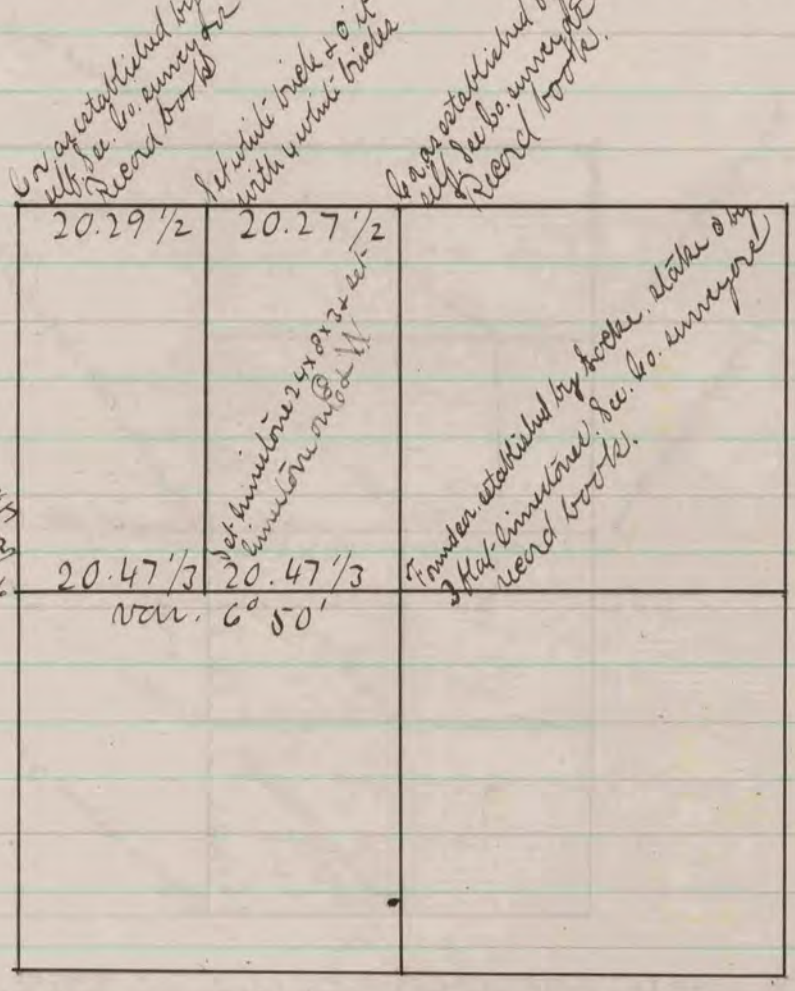

The above is a plat & record of a survey made by me. Mar. 20, 1871, in Sec. 17 Jamesville

Edward Ruger
Co. Surveyor

COUNTY SURVEYOR
RECORD 1859-1906