COUNTY SURVEYOF
RECORD 1 1851-18

213

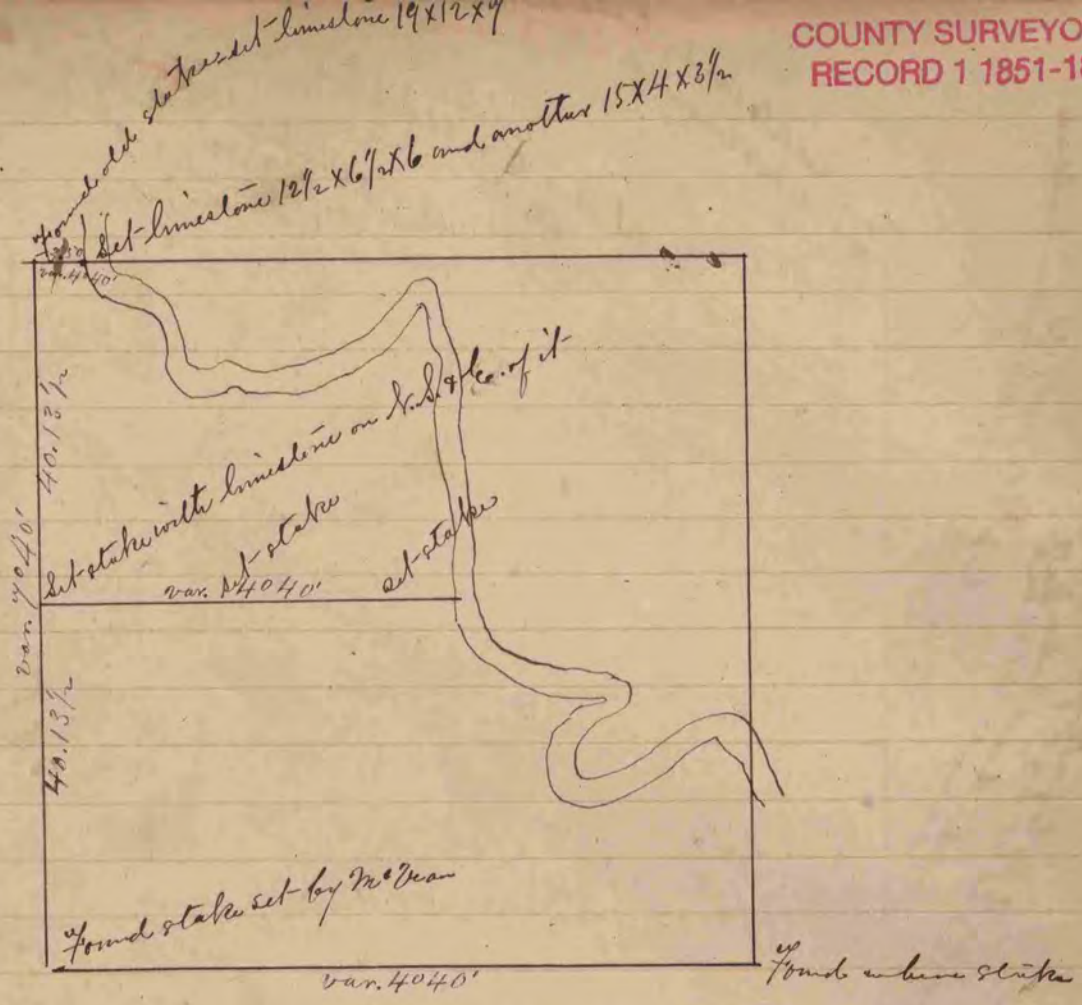

A Record & Plat of a Survey made on Sec. 28 Avon Dec. 6, 1864 by S.D. Locke County Surveyor in and for Rock Co. Wis.

Avon

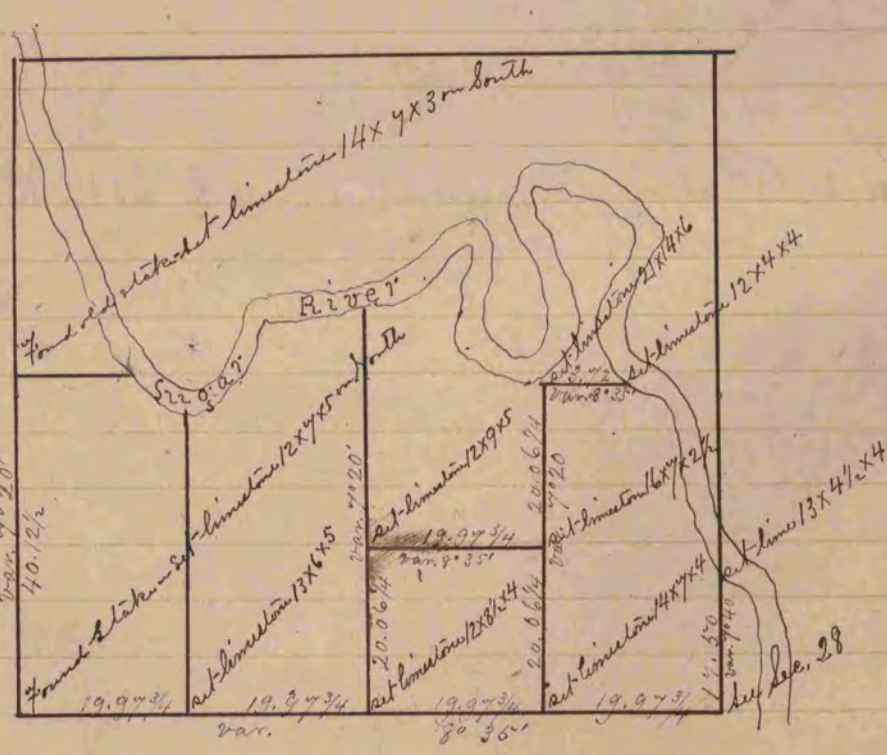

A Record & Plat of a Survey made on Sec. 20, Avon, Dec. 7, 1864, by S.D. Locke, County Surveyor in and for Rock Co Wis.

Avon

N.B.—Ran the E. line the same course as the W. line of Sec. 28, that being probably the way it was run by the Government Surveyor. Ran the meand. N.E. 36 and E. & W. lines the same course and precisely as the West and South lines; the only known lines in the Fractional Sec. run by S.D. Locke.