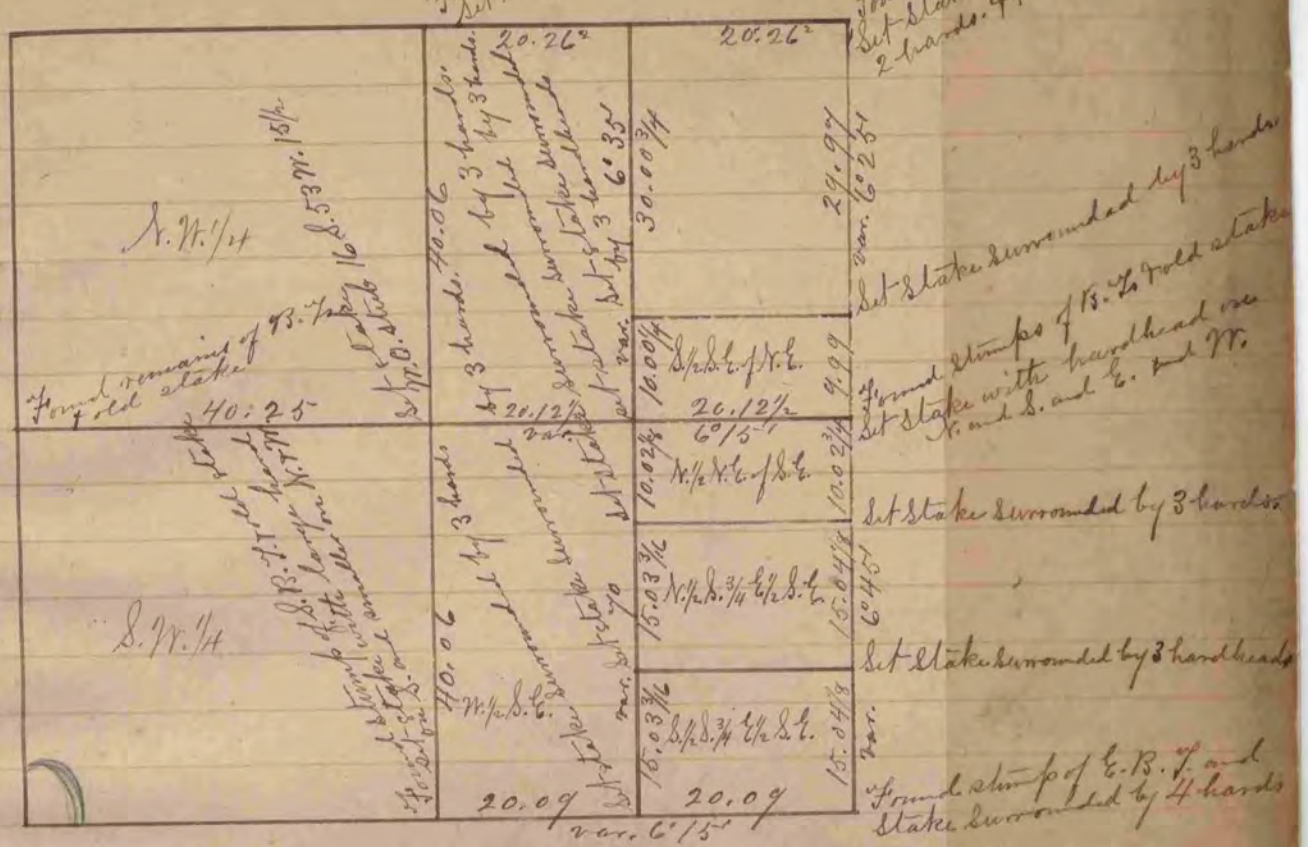
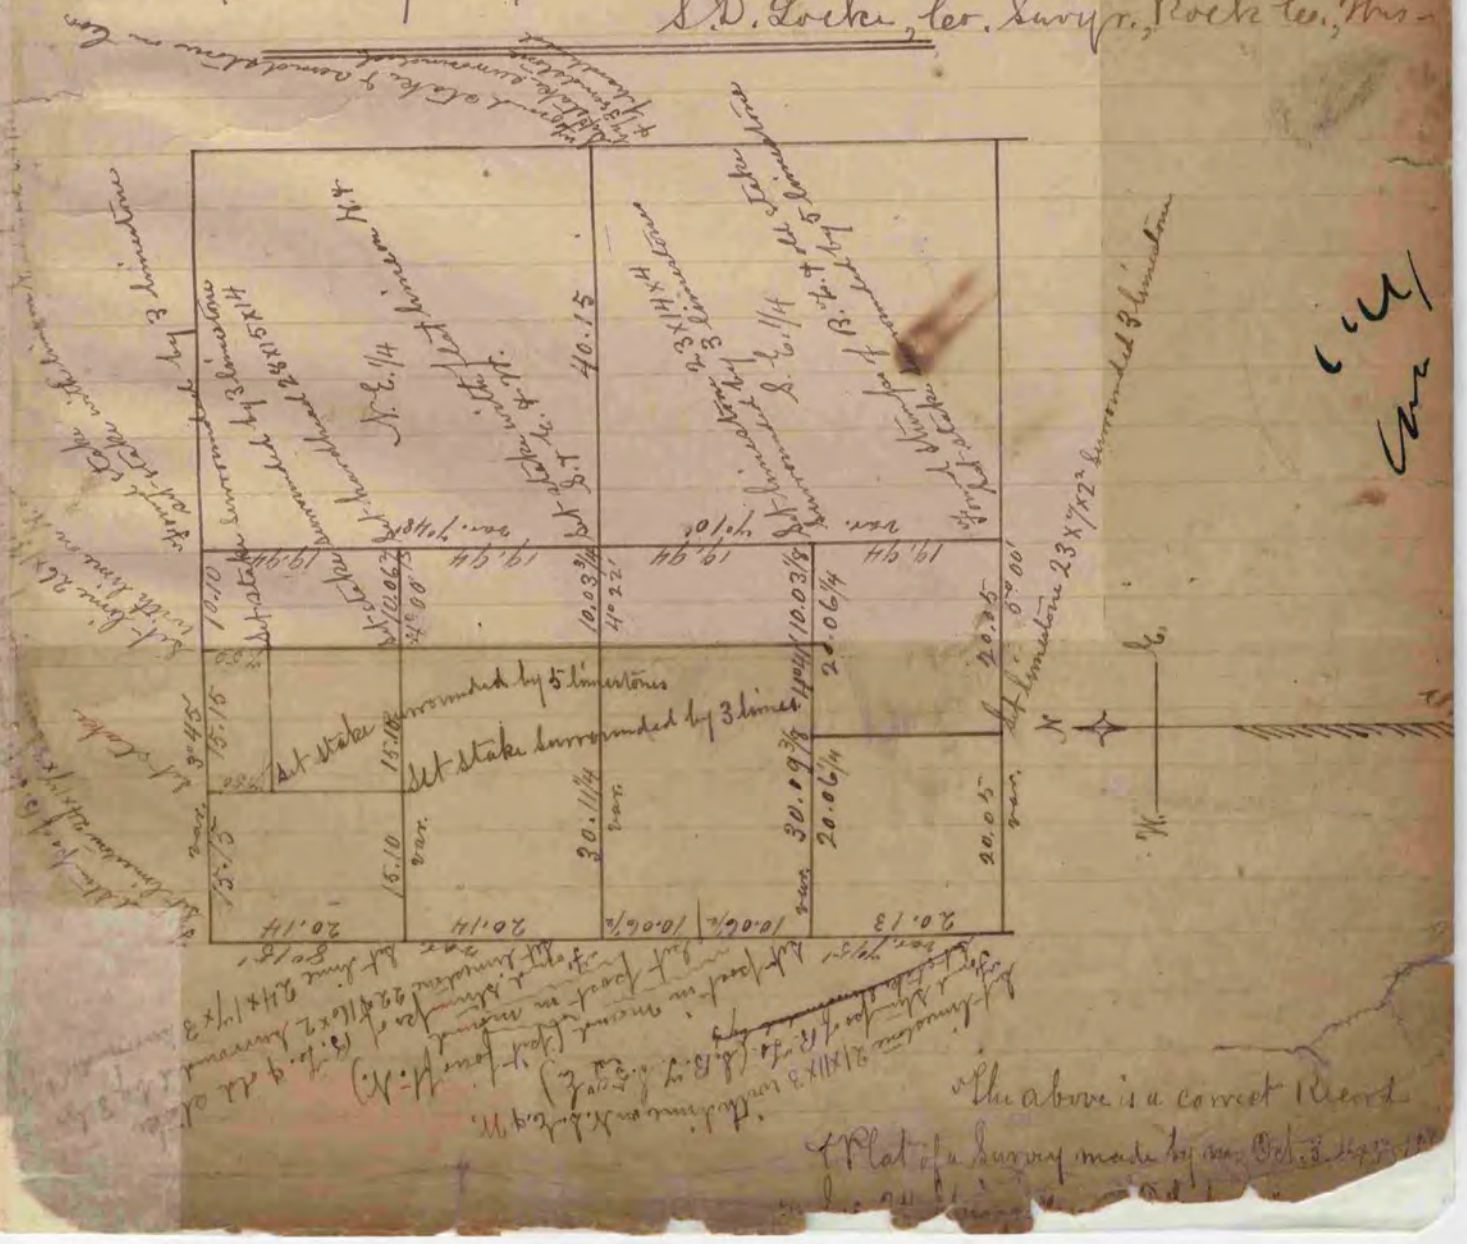
"The above is a correct Record Plat of a Survey made by me July 16 & 17, A.D. 1866, on Sec. 23 in the Town of Clinton —
S.D. Locke, Cor. Surveyor, Rock Co., Wis —