COUNTY SURVEY
RECORD 1859-1

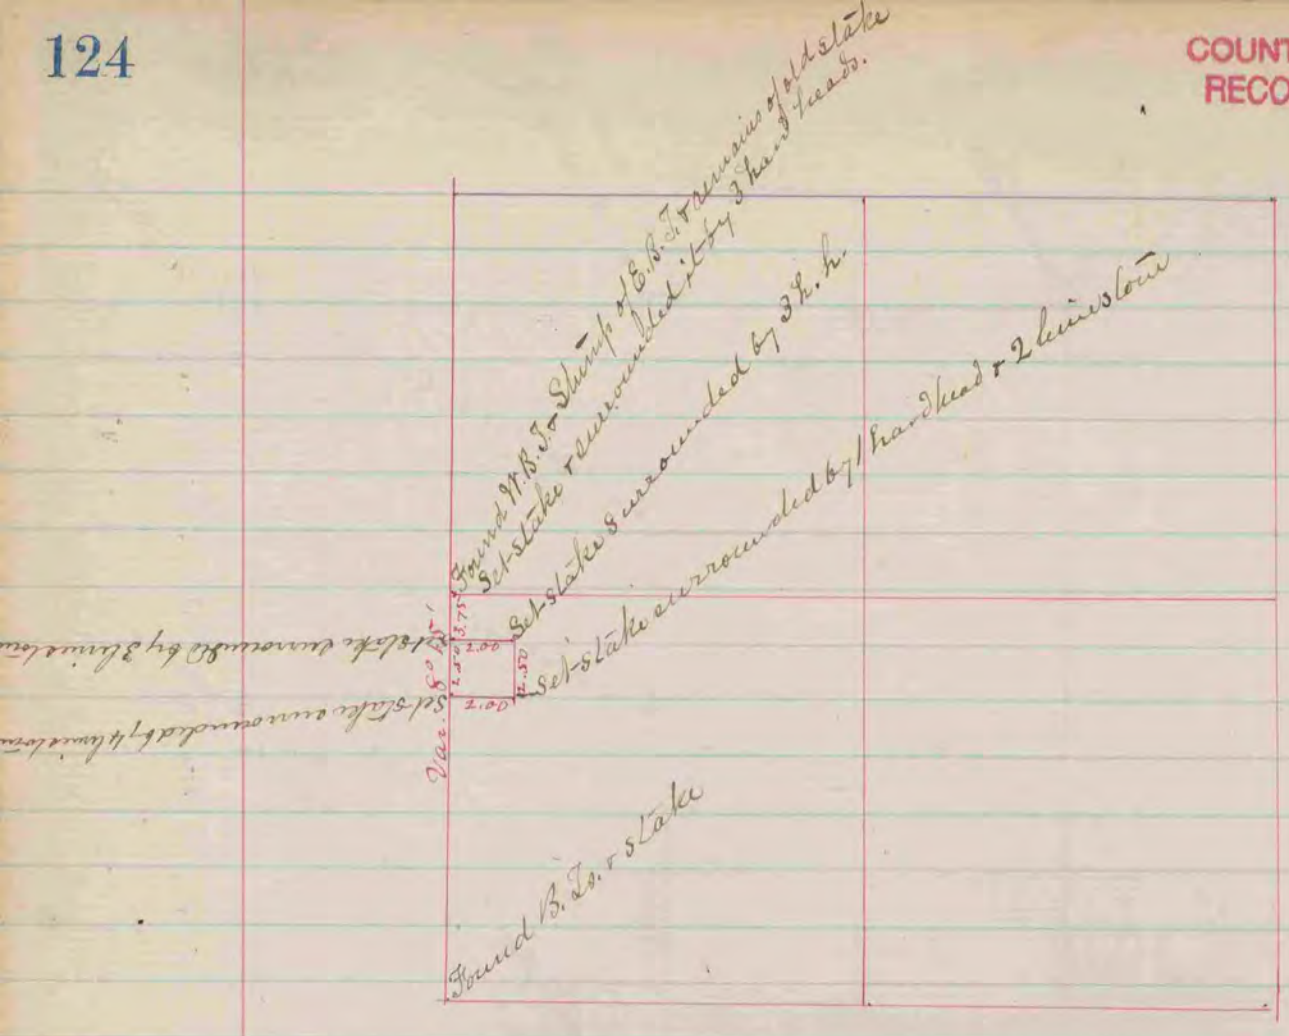

The E & W. lines are at right angles to N. Sec. line
The above is a correct Record & Plat of a survey of a school house lot made by me May 17. 1866 on Sec. 8. Spring Valley

S. D. Locke Spring Valley

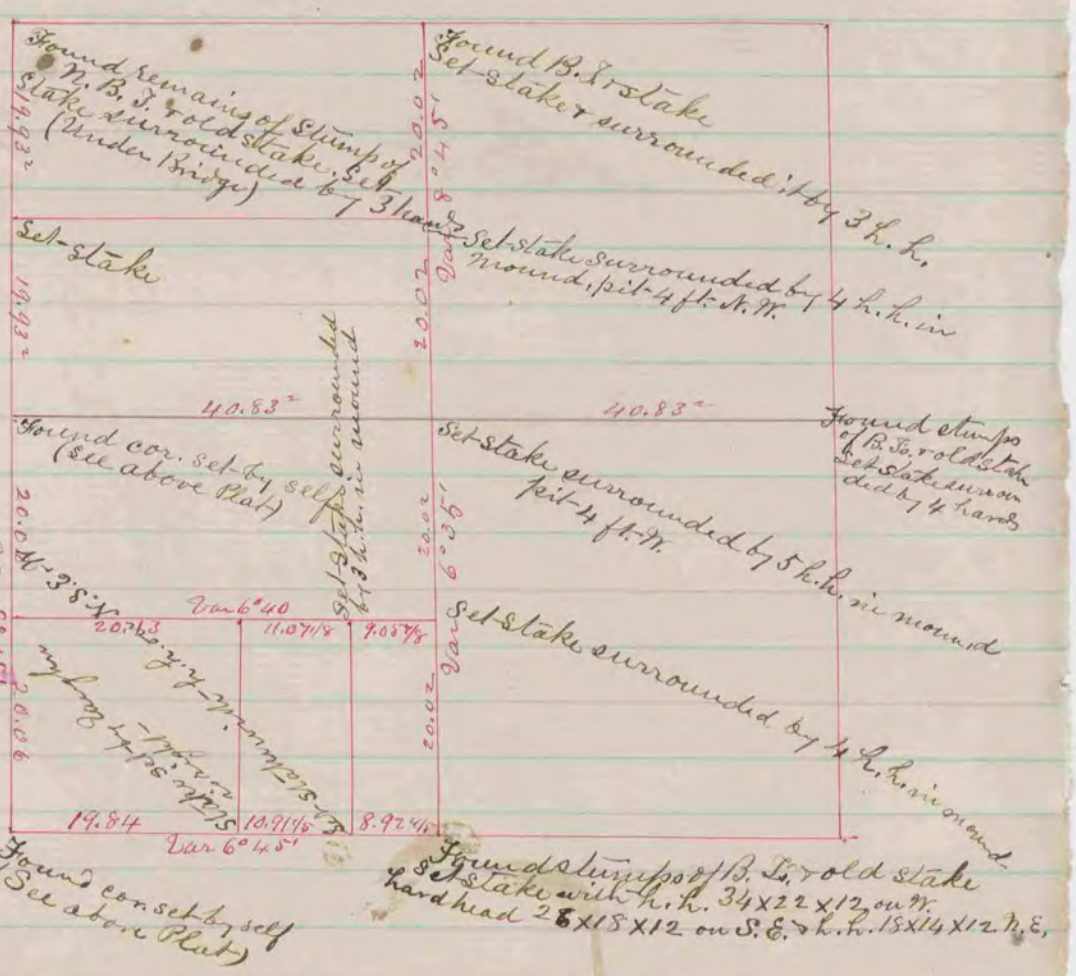

The above is a correct Record & Plat of a Survey made by me May 18. 1866 on Sec. 8. Spring Valley

S. D. Locke

Co. Surveyor