COUNTY SURVEYOR
RECORD 1859-1906

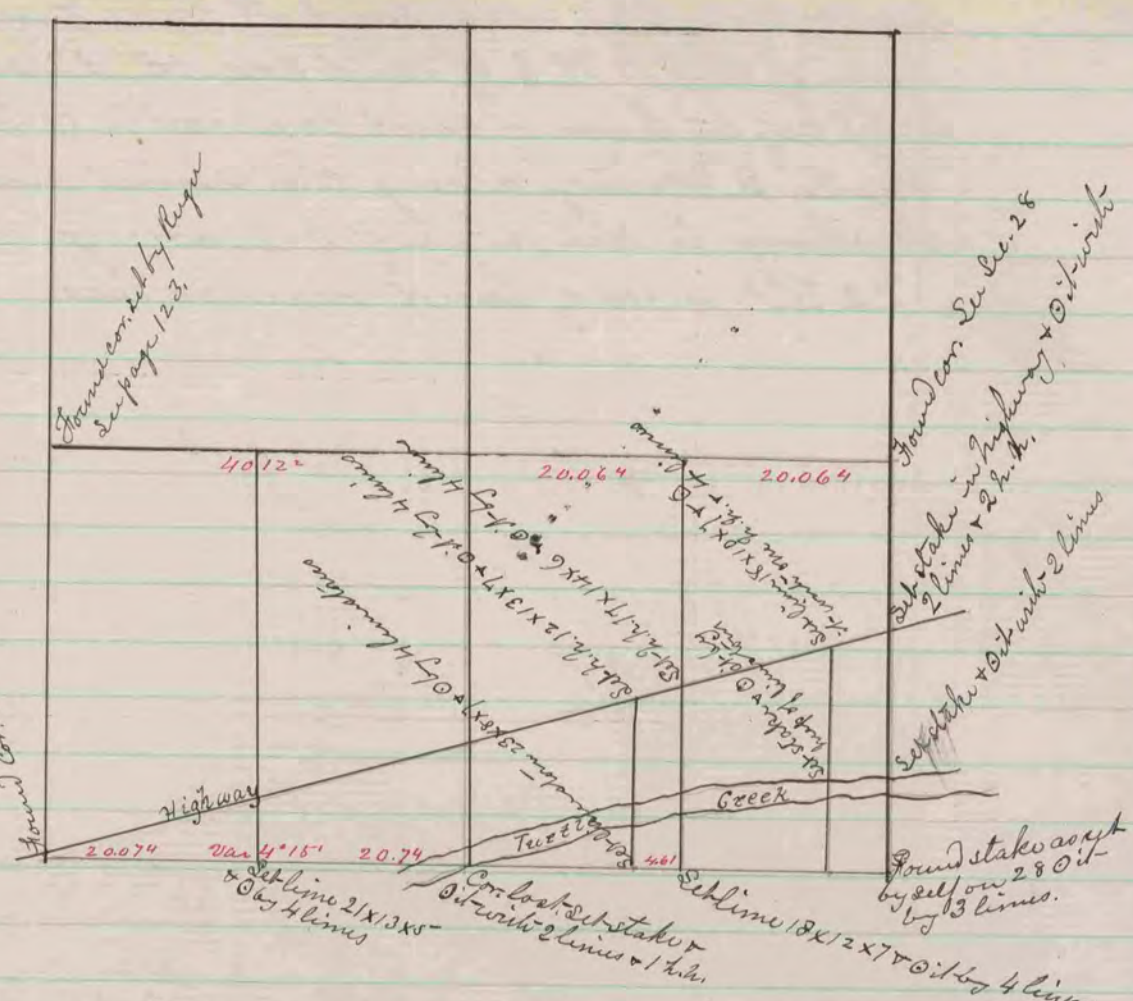

Bradford

A Record + plat of a survey made by me June 26 + 17. 1865 on Lec 29. Town of Bradford

S. D. Locke Co. Surveyor

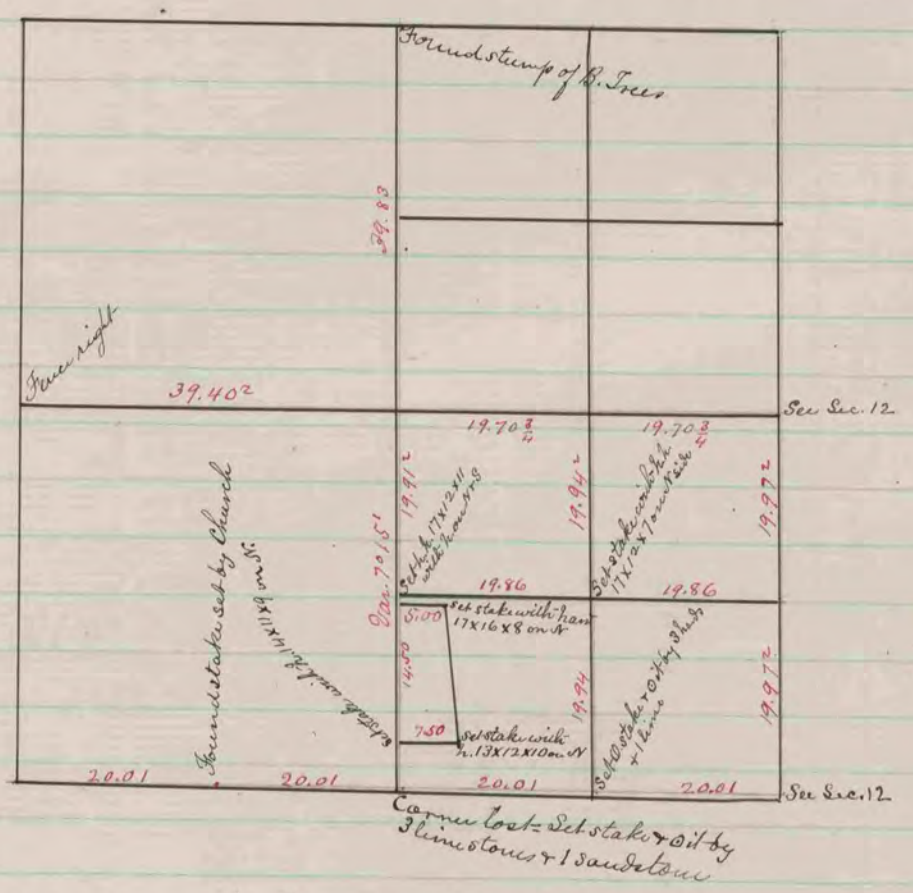

The above is a correct Record + Plat of a survey made by me July 6 + 7, 1865. Sec. 11. Town of Plymouth.

S. D. Locke Co. Surveyor