COUNTY SURVEYOR
RECORD 2 1869-1900

Below is a record and plat of a Survey made by me April 28th 1880 on Section 11, Rock; S.C. Wood and self, Chainmen. R.K. Lee, Dept Co. Surveyor

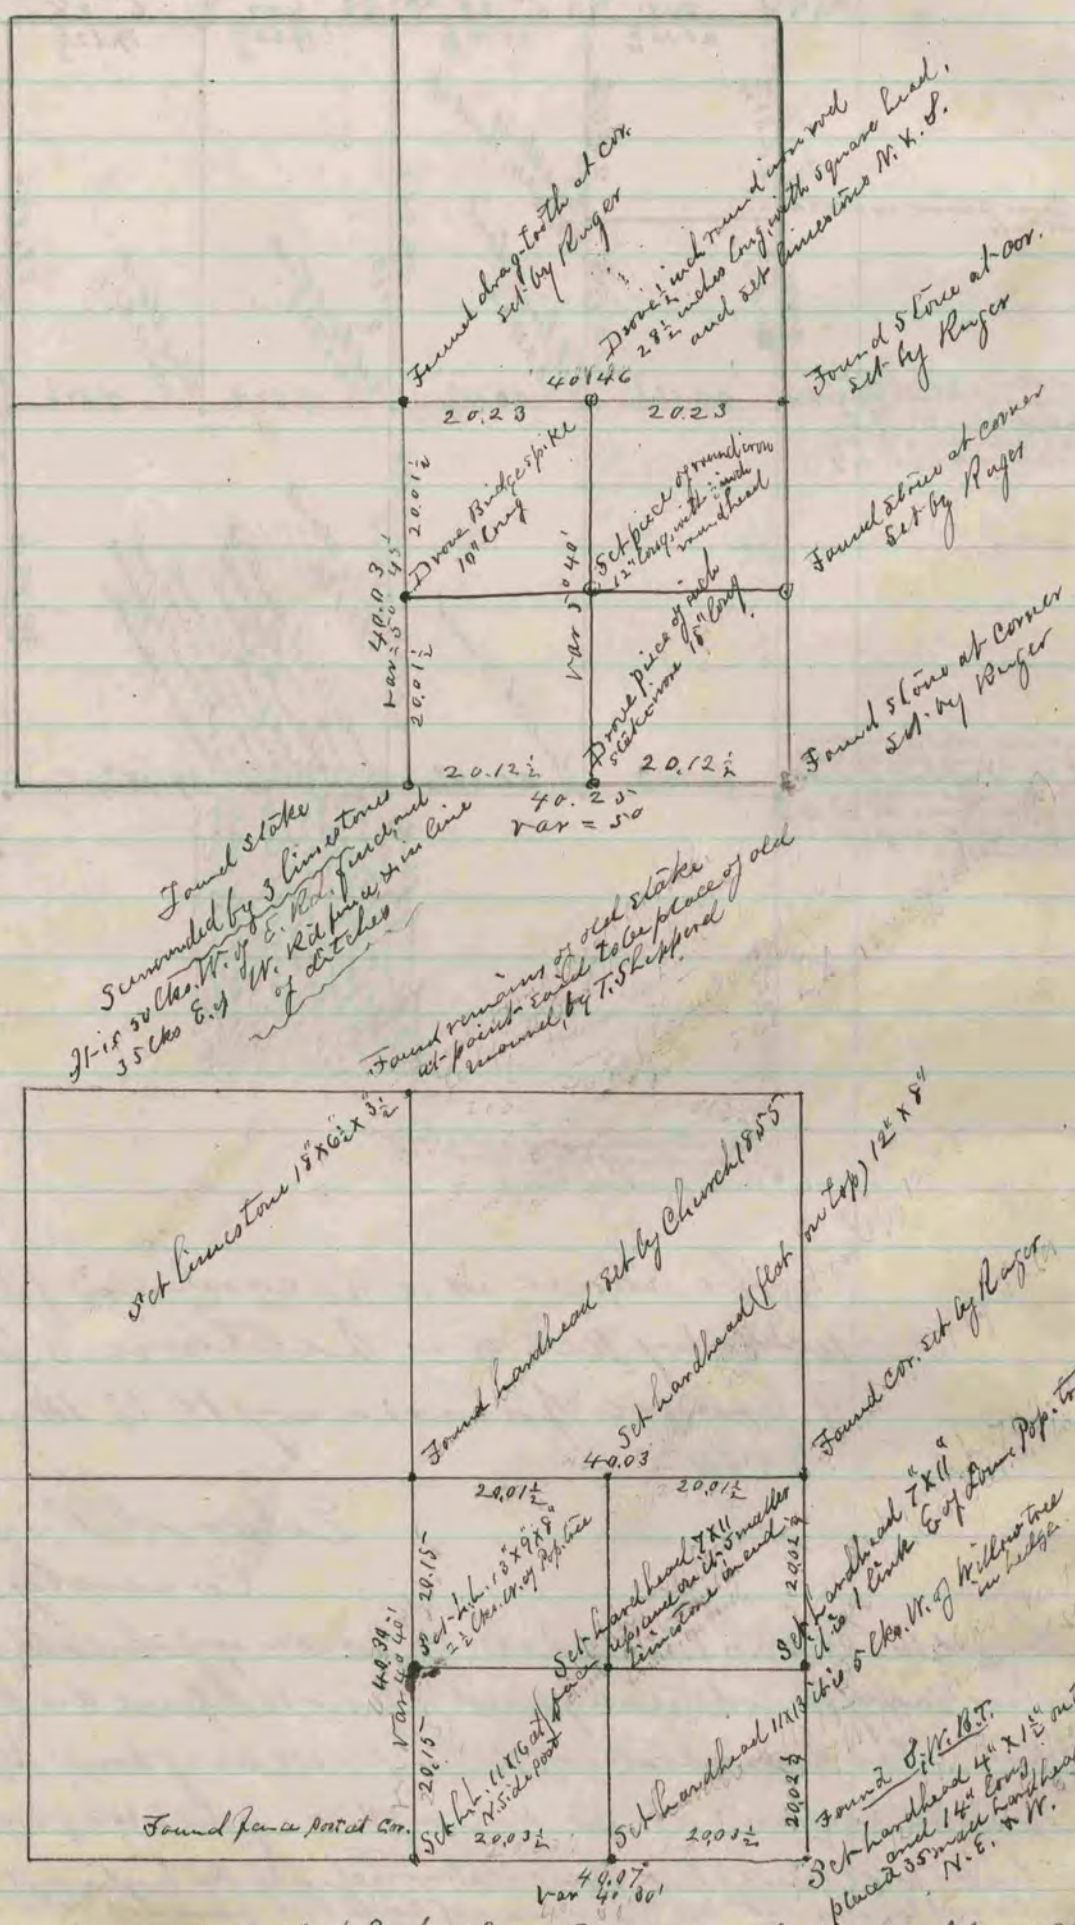

The above is a record and plat of a Survey made by me May 13th 1880 on Section 10 Clinton, S. Lake Jr & Self Chainmen

R.K. Lee, Dept Co. Surveyor